


T23S. R4W.WM

SCALE 1" = 1320'

JAN - 7 - 1991

WATER RESOURCES DEPT.
SALEM, OREGON

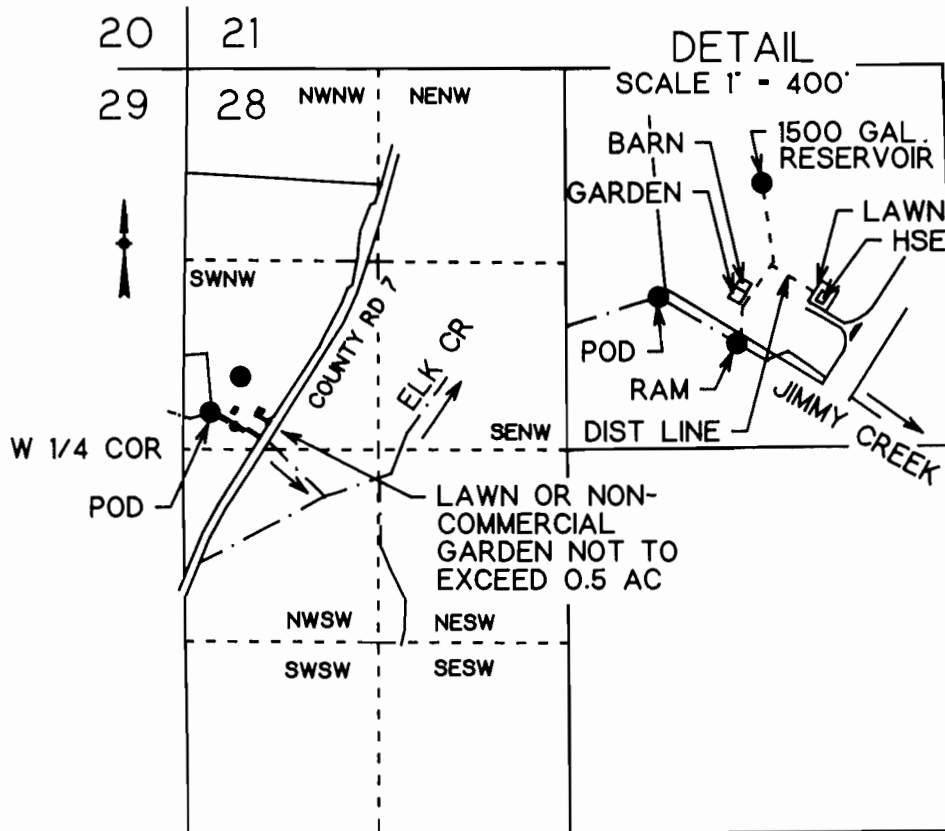

POD IS 260 FT N AND 190 FT E FROM W 1/4 COR SEC 28

FINAL PROOF SURVEY
UNDER

Application No. 70316 Permit No. 51051

IN NAME OF

JACK G OR ROSALIND KING

Surveyed October 27, 1992 by M E Farr

THIS IS A LOCATION MAP FOR A FINAL PROOF SURVEY BY JACK G OR ROSALIND KING. THIS MAP IS FOR THE PURPOSE OF IDENTIFYING THE LOCATION OF THE WATER RIGHT ONLY AND IS NOT INTENDED TO PROVIDE LEGAL DIMENSIONS OR LOCATIONS OF PROPERTY OWNERSHIP LINES.



1-93