
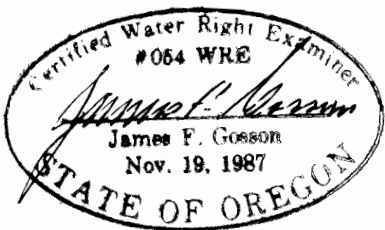


OCT 23 1996

RECEIVED

FINAL PROOF SURVEY MAP  
IN THE NAME OF RICHARD D. BUNNELL  
SECTION 16, T 26 S, R 4 W, W.M.  
APPLICATION 70330 PERMIT 51244

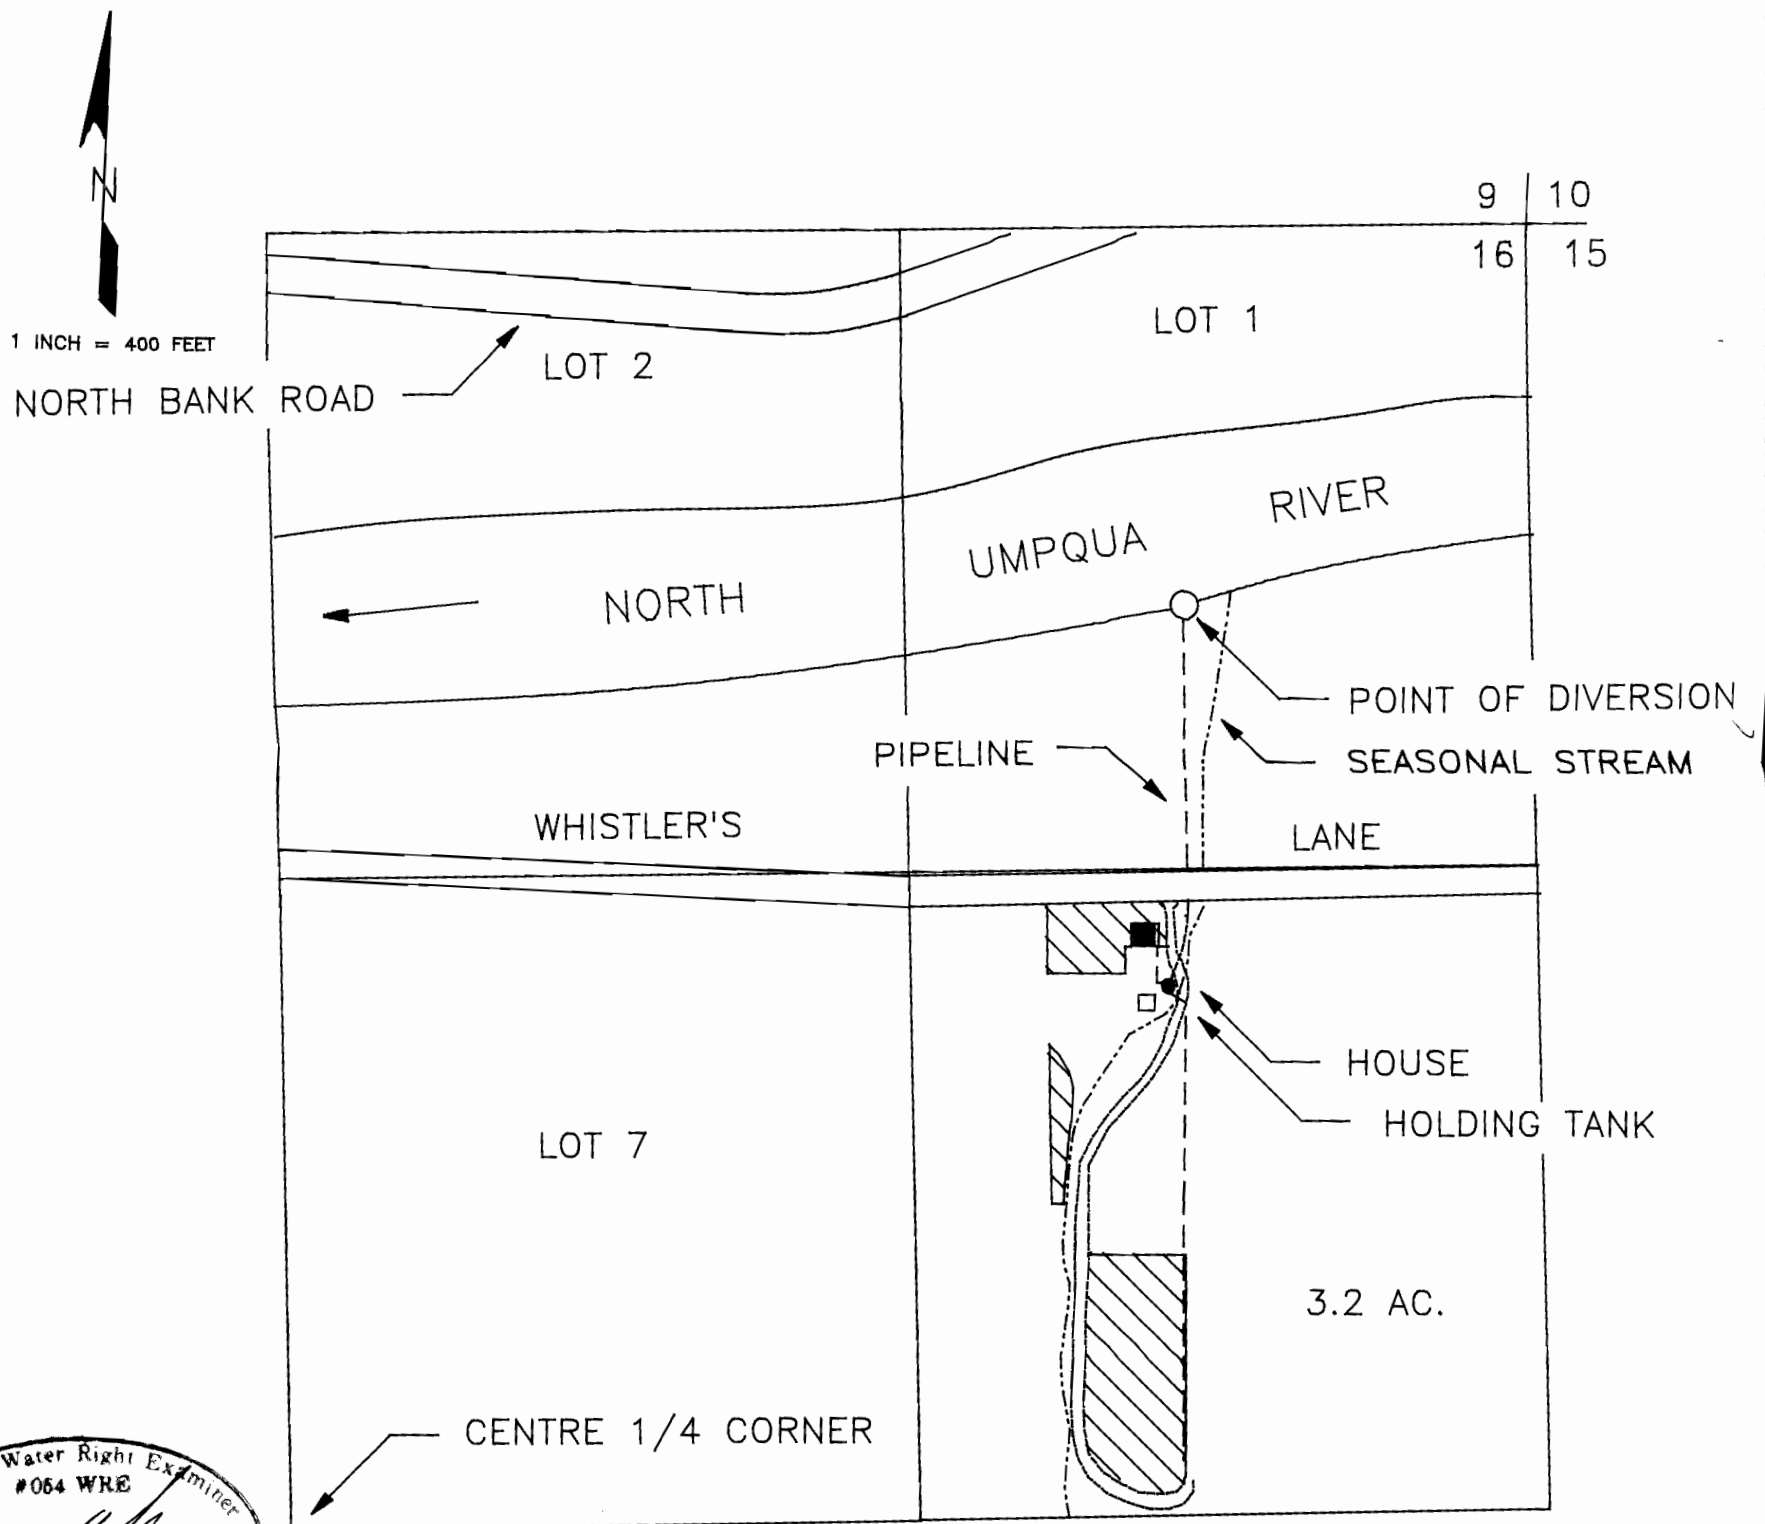

THE POINT OF DIVERSION IS LOCATED 800 FEET SOUTH AND 730 FEET WEST FROM THE NORTHEAST CORNER OF SECTION 16, BEING WITHIN THE NE 1/4 OF THE NE 1/4 OF SECTION 16, TOWNSHIP 26 SOUTH, RANGE 4 WEST, W.M.

THE PURPOSE OF THIS MAP IS TO IDENTIFY THE LOCATION OF THE WATER RIGHT. IT IS NOT INTENDED TO PROVIDE INFORMATION RELATIVE TO THE LOCATION OF PROPERTY OWNERSHIP BOUNDARY LINES.