


# T27S, R5W, WM

SCALE 1" = 1320'

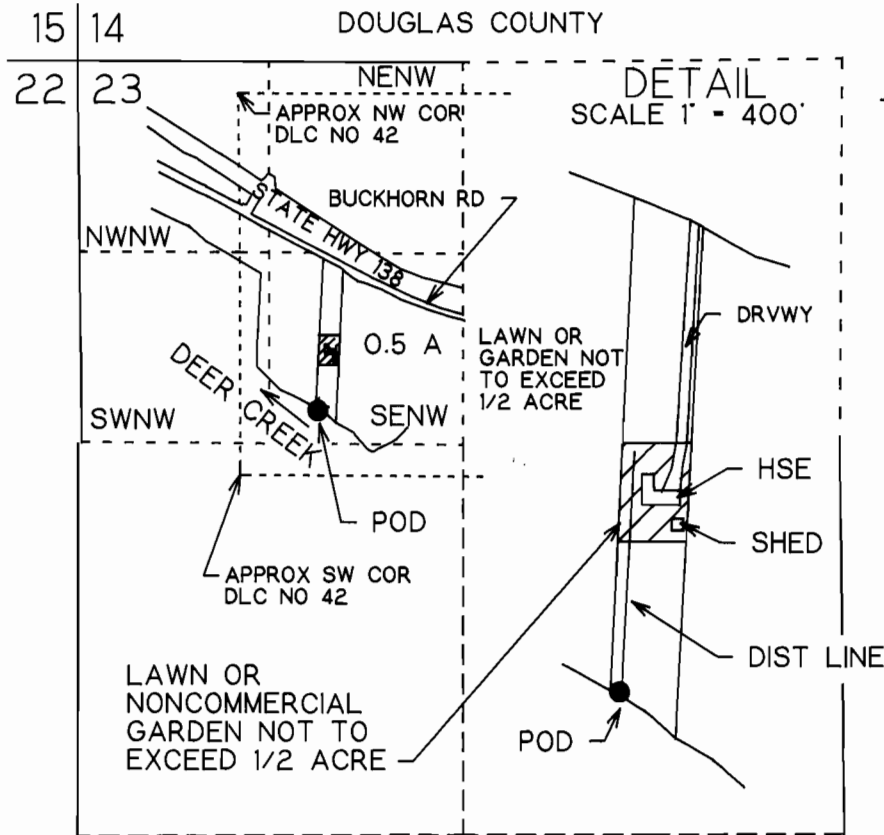

POD IS 2370 FT S AND 990 FT W FROM N 1/4 COR SEC 23

## FINAL PROOF SURVEY UNDER

Application No. 70380 Permit No. 51068

IN NAME OF

SUSAN LAVIN or JERRY MONEKE

Surveyed September 11, 1993 by M E Farr

THIS IS A LOCATION MAP FOR A FINAL PROOF SURVEY BY SUSAN LAVIN OR JERRY MONEKE. THIS MAP IS FOR THE PURPOSE OF IDENTIFYING THE LOCATION OF THE WATER RIGHT ONLY AND IS NOT INTENDED TO PROVIDE LEGAL DIMENSIONS OR LOCATIONS OF PROPERTY OWNERSHIP LINES.



EXPIRES 12-31-93