


RECEIVED

1995

RESOURCES DEPT
OREGON

T.30S.,R.4W,W.M.

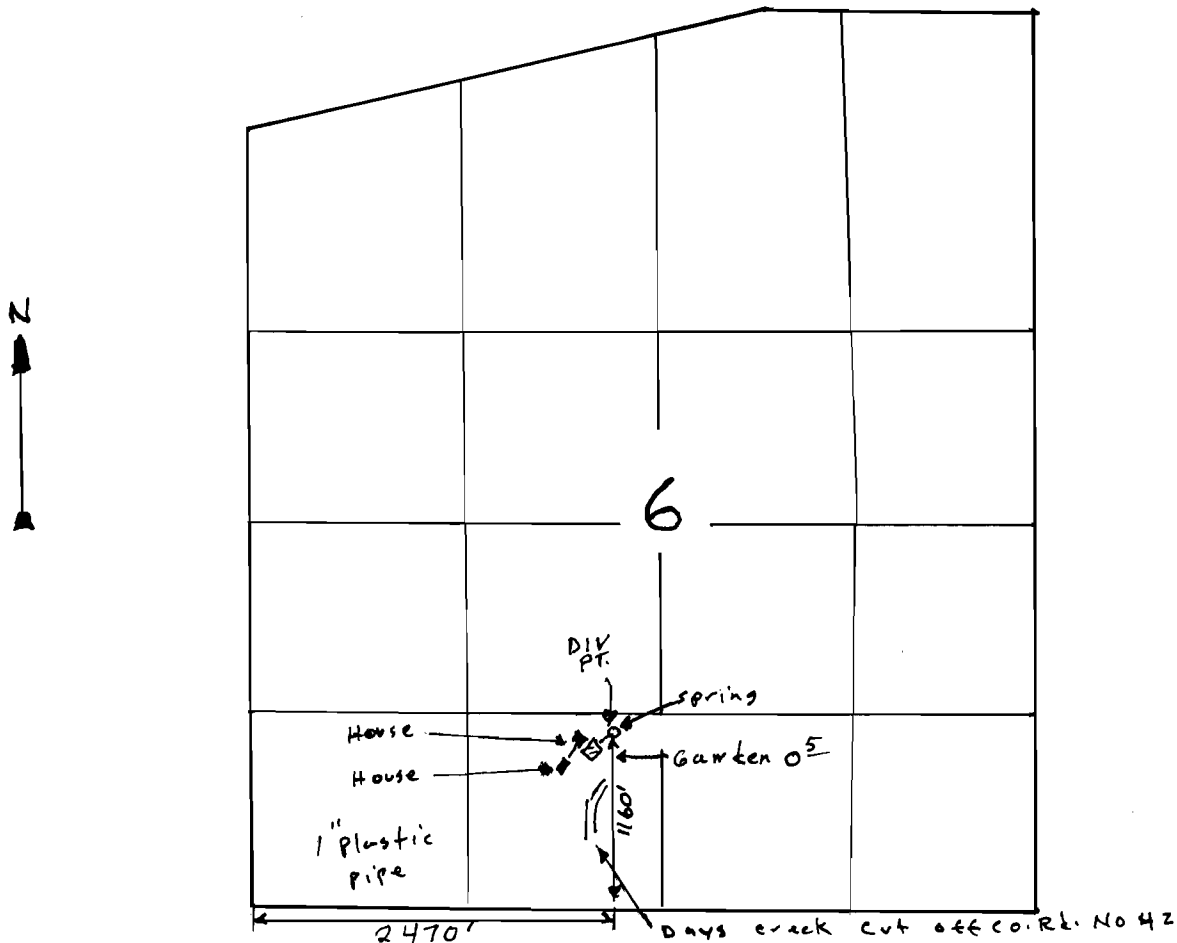

THE PURPOSE OF THIS MAP IS TO
IDENTIFY THE LOCATION OF THE
WATER RIGHT. IT IS NOT INTENDED
TO PROVIDE INFORMATION RELATIVE
TO THE LOCATION OF PROPERTY
OWNERSHIP BOUNDARY LINES.

FINAL PROOF SURVEY
UNDER



Application No. 70499 Permit No. 51284
IN NAME OF

MABLE M. SMITH


Surveyed Jan 8 1995 by DUANE KIRBY

RECEIVED

1995


RESOURCES DEPT
OREGON

T.30S.,R.4W,W.M.

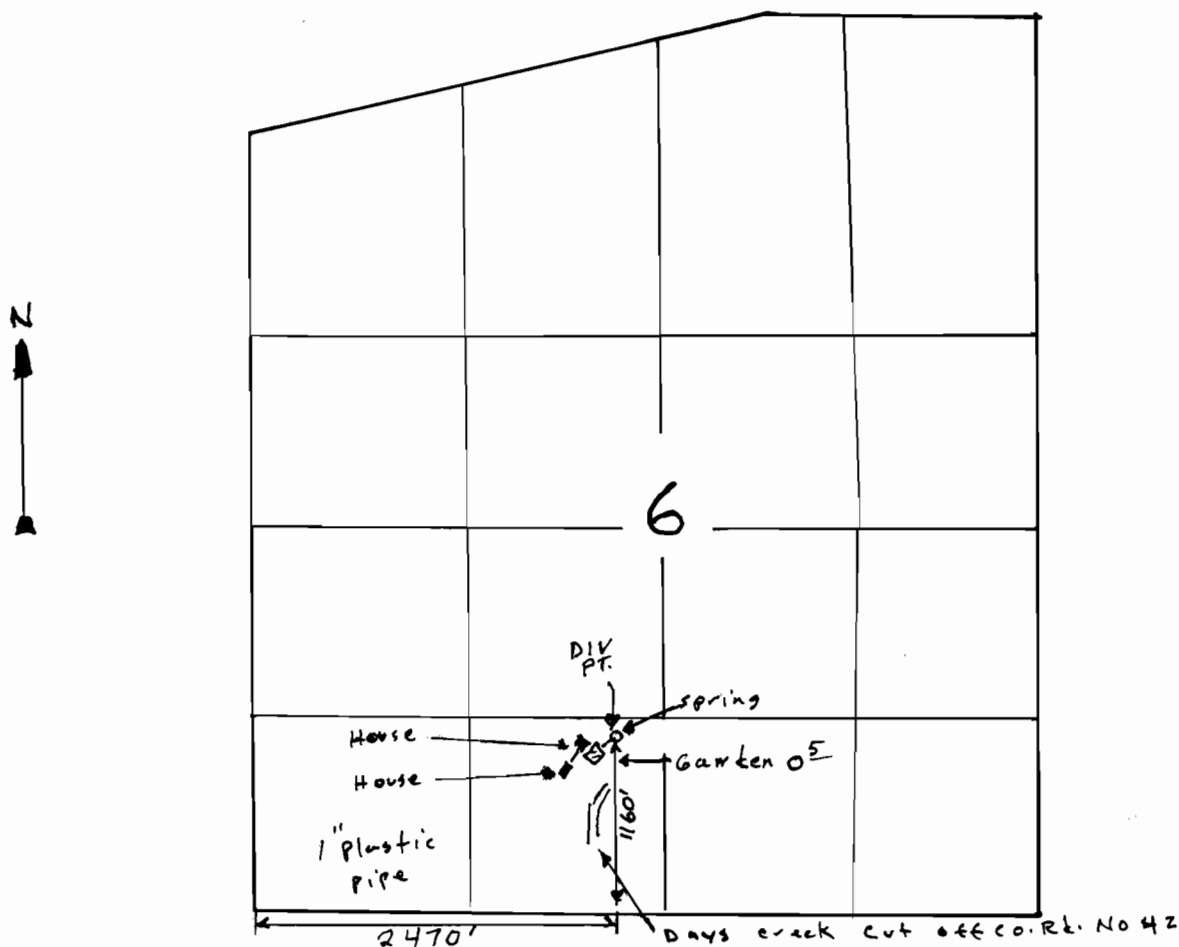

THE PURPOSE OF THIS MAP IS TO
IDENTIFY THE LOCATION OF THE
WATER RIGHT. IT IS NOT INTENDED
TO PROVIDE INFORMATION RELATIVE
TO THE LOCATION OF PROPERTY
OWNERSHIP BOUNDARY LINES.

FINAL PROOF SURVEY
UNDER

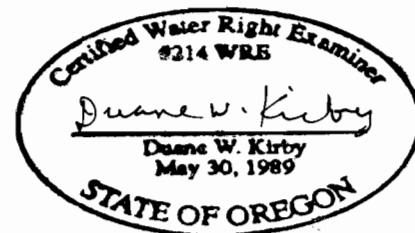

Application No. 70499 Permit No. 51284
IN NAME OF

MABLE M. SMITH

Surveyed Jan 8 1995 by DUANE KIRBY