


T26S, R3W, WM

DOUGLAS COUNTY

SCALE 1" = 1320'

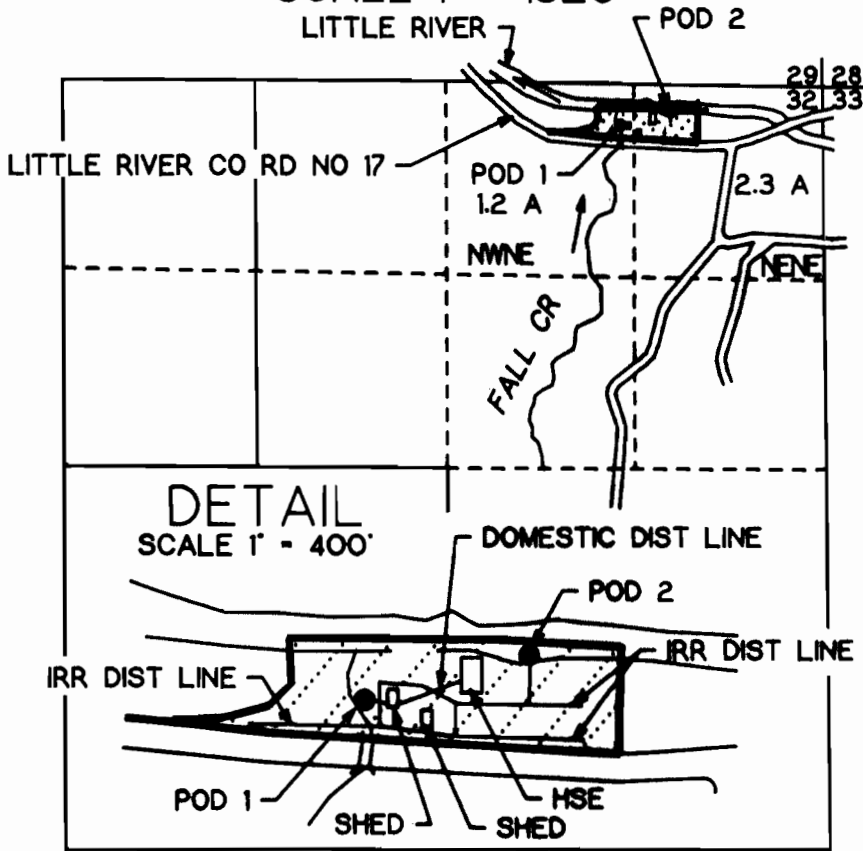

RECEIVED

SEP 27 1995

POD 1 IS 260 FT S AND 1390 FT W FROM NE COR SEC 32  
 POD 2 IS 170 FT S AND 1050 FT W FROM NE COR SEC 32

WATER RESOURCES DEPT.  
 SALEM, OREGON

FINAL PROOF SURVEY  
 UNDER

Application No. 70541 Permit No. 51311

IN NAME OF

LAWRENCE D. OR AGNES R. AAMOT

Surveyed Sept 20, 1995 by M.E. Farr

THIS IS A LOCATION MAP FOR A FINAL PROOF SURVEY BY LAWRENCE D OR AGNES R AAMOT. THIS MAP IS FOR THE PURPOSE OF IDENTIFYING THE LOCATION OF THE WATER RIGHT ONLY AND IS NOT INTENDED TO PROVIDE LEGAL DIMENSIONS OR LOCATIONS OF PROPERTY OWNERSHIP LINES.

Certified Water Right Examiner  
 #046 WRE  
*Maurice E. Farr*  
 Maurice E. Farr  
 Nov. 19, 1987  
 STATE OF OREGON 9-95

EXPIRES 12-31-95