



T.26S.,R.3W.,W.M.

SECTION 17

SCALE 1" = 400'

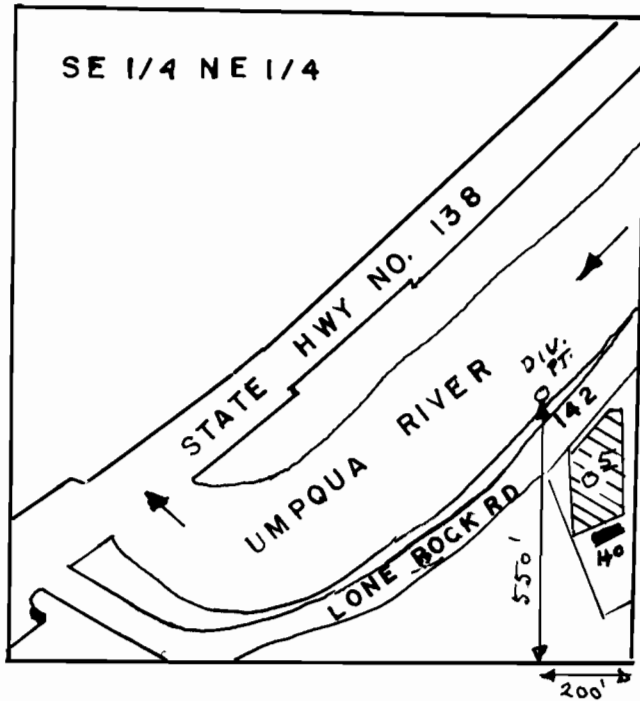

THE PURPOSE OF THIS MAP IS TO IDENTIFY THE LOCATION OF THE WATER RIGHT. IT IS NOT INTENDED TO PROVIDE INFORMATION RELATIVE TO THE LOCATION OF PROPERTY OWNERSHIP BOUNDARY LINES

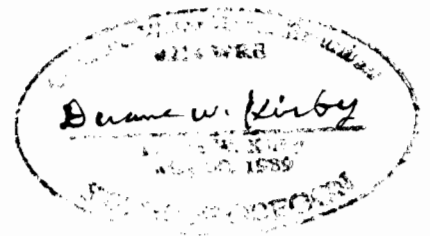

FINAL PROOF SURVEY
UNDER

Application No. 70630 Permit No. 51151
IN NAME OF

PAUL & BERNICE ORR

Surveyed AUG 29 1994 by DUANE KIRBY