


T30S R3W WM, SECTION 7

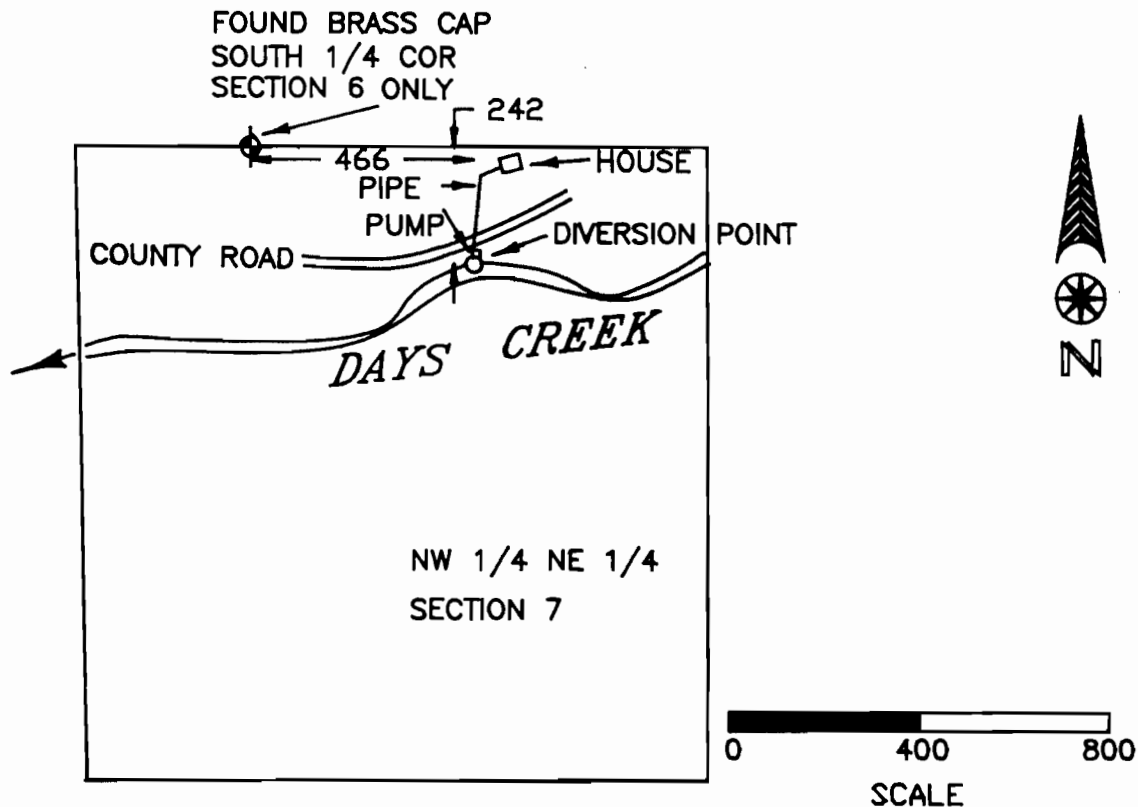

THIS MAP TO BE USED FOR WATER RIGHT PURPOSES ONLY

MAP FOR FINAL PROOF SURVEY
PERMIT NUMBER 51361
IN NAME OF

MANUEL J. GOMES

DATE JANUARY 28, 1995

BY: WILLIAM J. RUPPERT
P.O. BOX 1564
MYRTLE CREEK, OR 97457

RECEIVED

JUL 12 1995

WATER RESOURCES DEPT.
SALEM, OREGON

