


8 9  
17 16

9 1/4 S  
16



Scale: 1" = 200 ft.

Point of diversion is 100 feet South & 1,580 feet East of the NW corner of Section 16.

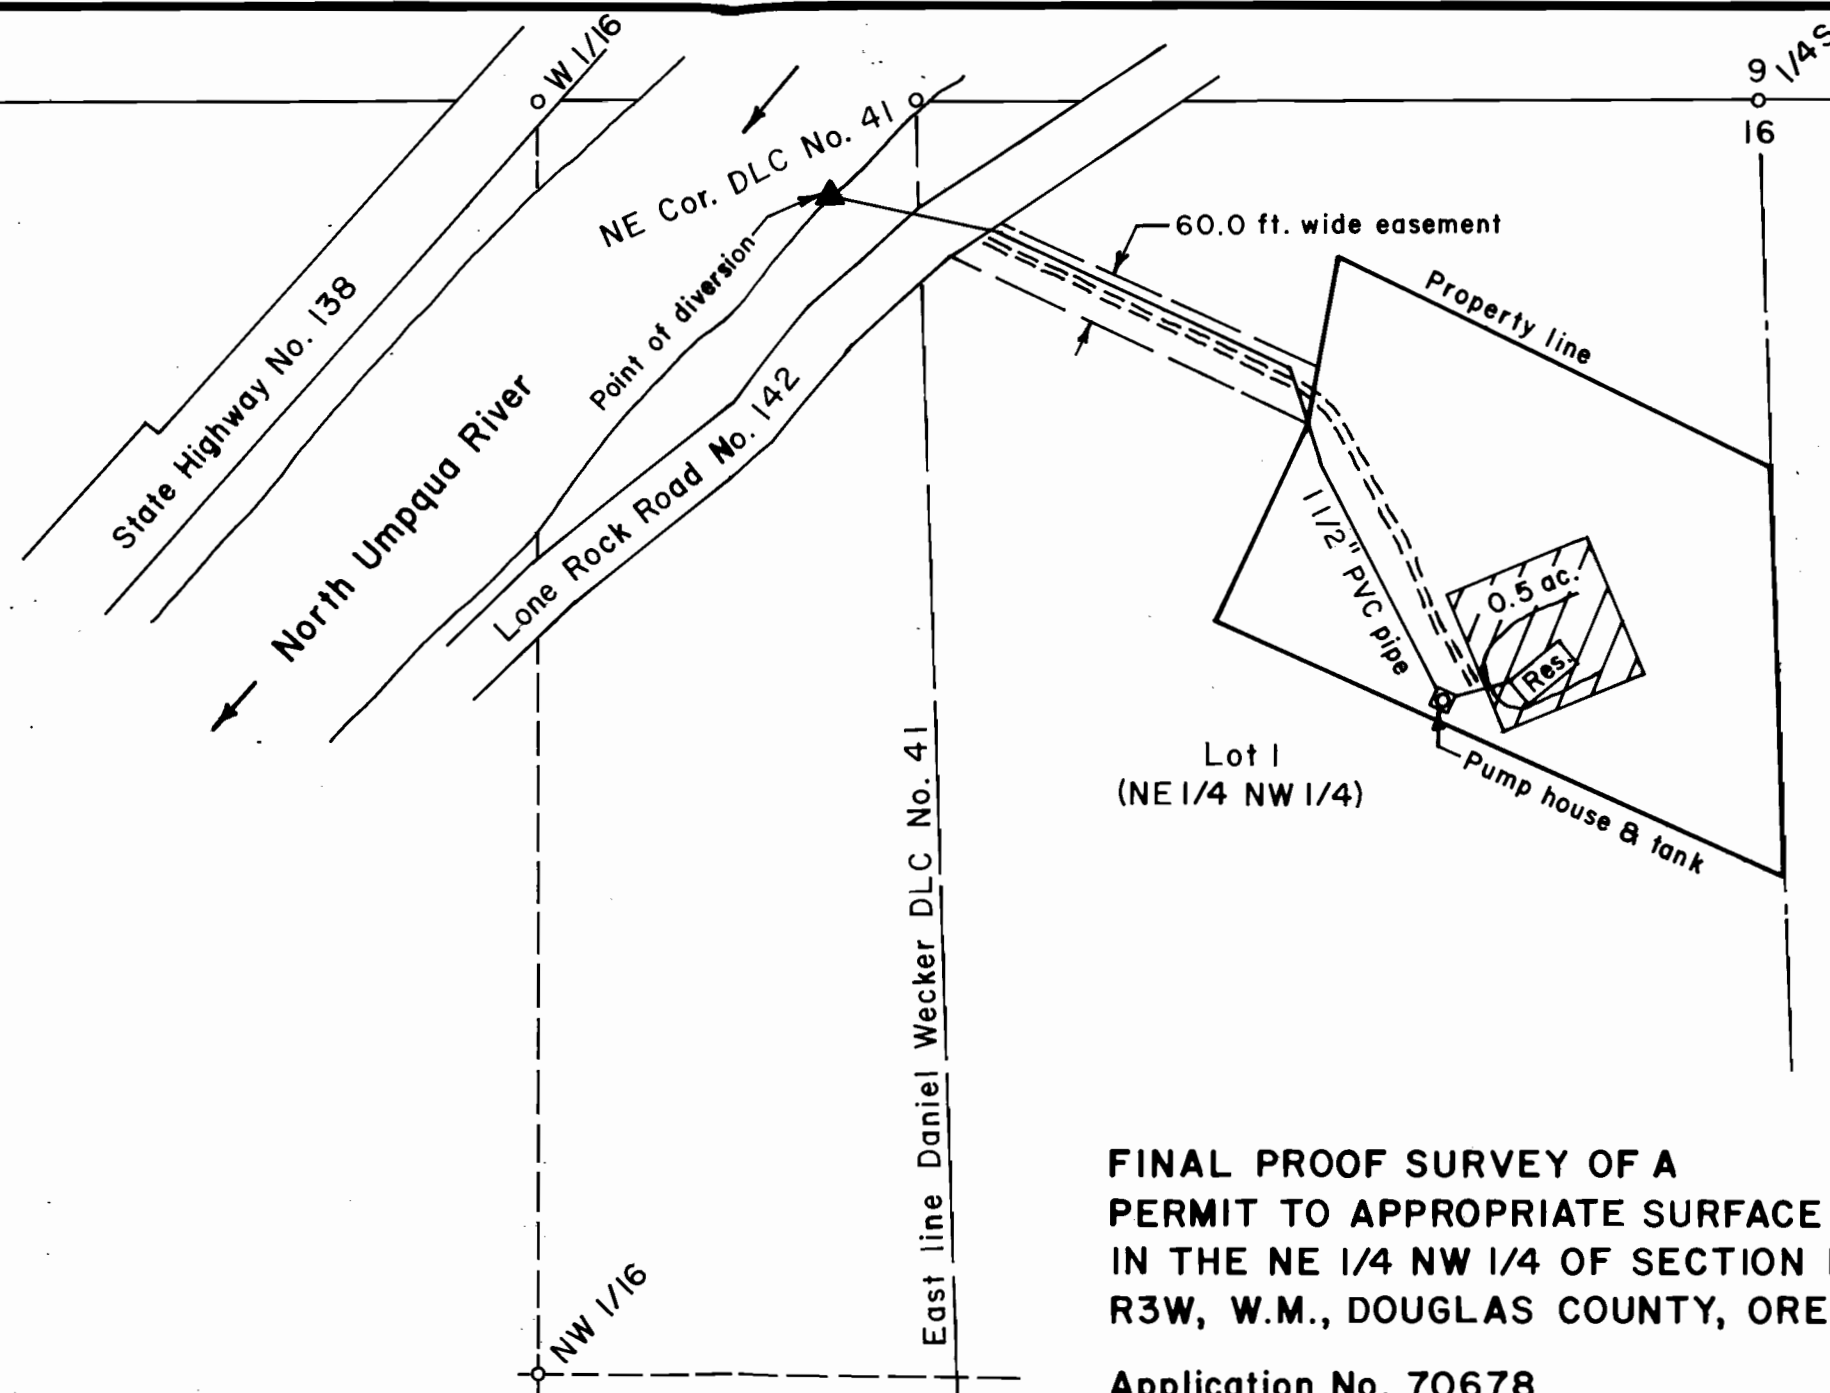


**FINAL PROOF SURVEY OF A  
PERMIT TO APPROPRIATE SURFACE WATER  
IN THE NE 1/4 NW 1/4 OF SECTION 16, T26S,  
R3W, W.M., DOUGLAS COUNTY, OREGON**

**Application No. 70678  
Permit No. 51260**

For: William A. & Mary E. Fitzgerald  
927 Lone Rock Road  
Glide, Oregon 97443

By: Shaner Engineering, Inc.  
P.O. Box 1430  
Roseburg, Oregon 97470

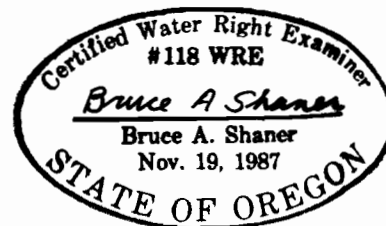

Renews June 30, 1996

September 22, 1995