

Scale: 1" = 200 ft.


Point of diversion is 100 feet South & 1,580 feet East of the NW corner of Section 16.

**FINAL PROOF SURVEY OF A
PERMIT TO APPROPRIATE SURFACE WATER
IN THE NE 1/4 NW 1/4 OF SECTION 16, T26S,
R3W, W.M., DOUGLAS COUNTY, OREGON**

Application No. 70678
Permit No. 51260

For: William A. & Mary E. Fitzgerald
927 Lone Rock Road
Glide, Oregon 97443

By: Shaner Engineering, Inc.
P.O. Box 1430
Roseburg, Oregon 97470

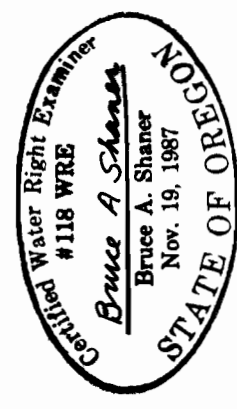

Renews June 30, 1996

September 22, 1995