


RECEIVED

AUG 16 1993

WATER RESOURCES DEPT.
SALEM, OREGON

T29S R4W WM
SECTION 11

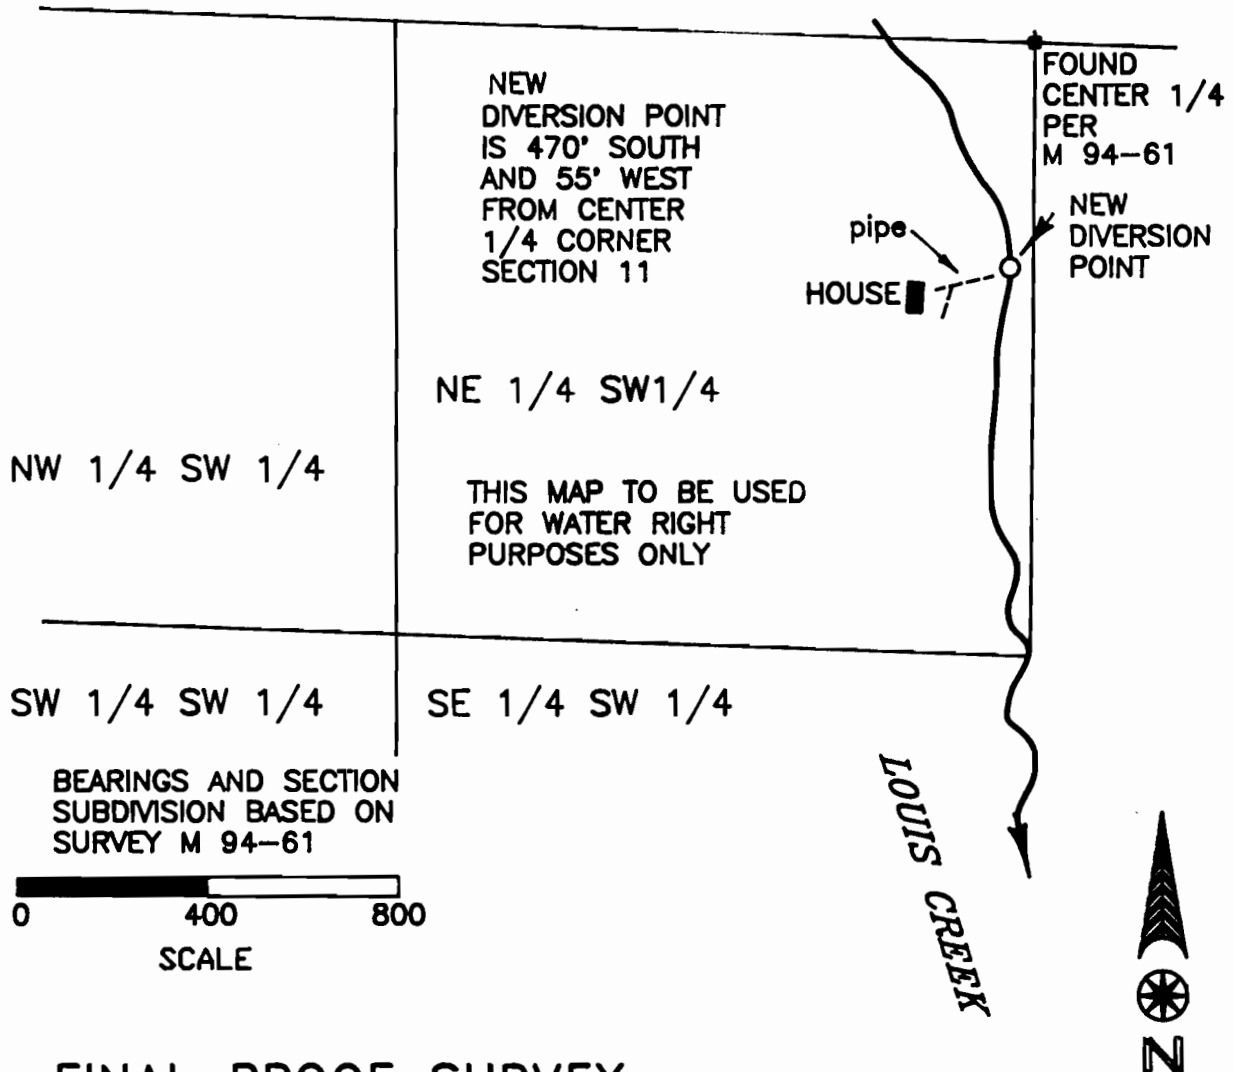

FINAL PROOF SURVEY
APPLICATION 71124
PERMIT 51267

IN NAME OF
Del Hamberger

REDRAWN FOR DEL HAMBERBER, AUGUST 1993

DATE JUNE 20, 1992

BY: WILLIAM J. RUPPERT
P.O. BOX 1564
MYRTLE CREEK, OR 97457

