

FINAL PROOF SURVEY MAP
IN THE NAME OF MARLEN E. AND CAROLYN FERCH

SECTIONS 17 & 20, TOWNSHIP 29, SOUTH, RANGE 4 WEST, W.M.



APPLICATION S-71310

PERMIT 52699

RECEIVED

OCT 29 1999

WATER RESOURCES DEPT.
SALEM, OREGON

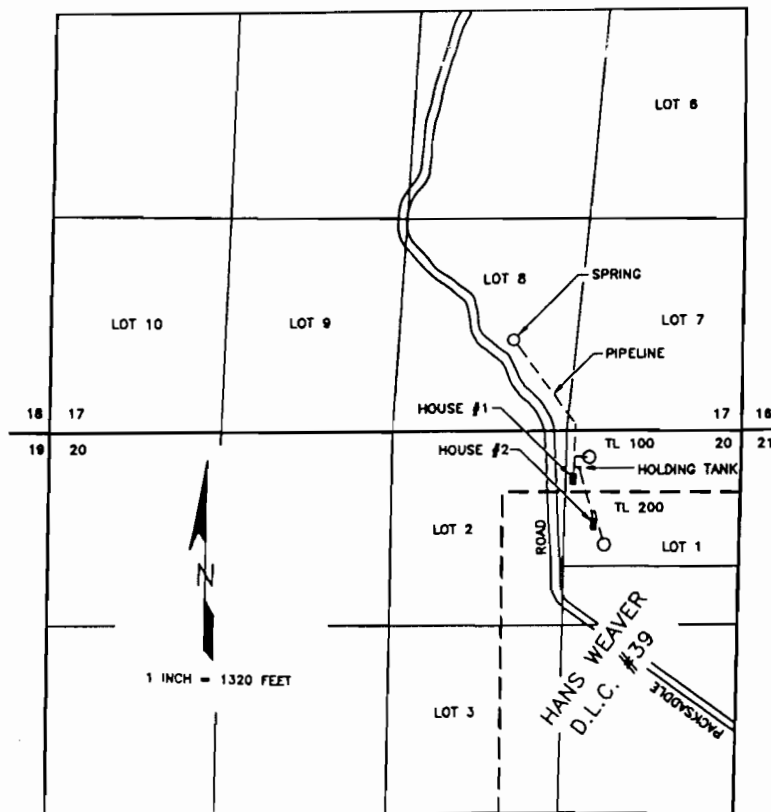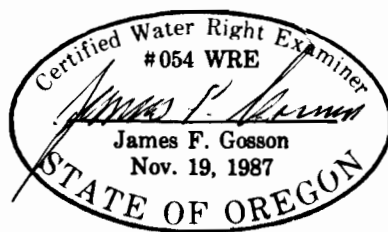

○ STOCKWATER

THE SPRING IS LOCATED 600 FEET NORTH AND 1500 FEET WEST FROM THE SOUTHEAST CORNER OF SECTION 17, BEING WITHIN THE SW 1/4 SE 1/4 SECTION 17, TOWNSHIP 29 SOUTH, RANGE 4 WEST, W.M., DOUGLAS COUNTY.

THE PURPOSE OF THIS MAP IS TO IDENTIFY THE LOCATION OF THE WATER RIGHT. IT IS NOT INTENDED TO PROVIDE INFORMATION RELATIVE TO THE LOCATION OF PROPERTY OWNERSHIP BOUNDARY LINES.