FINAL PROOF SURVEY MAP
IN THE NAME OF SCOTT VAN BUSKIRK AND/OR LESLIE C. SNOW
SECTION 32, TOWNSHIP 28 SOUTH, RANGE 7 WEST, W.M.
APPLICATION 71356 PERMIT 51221

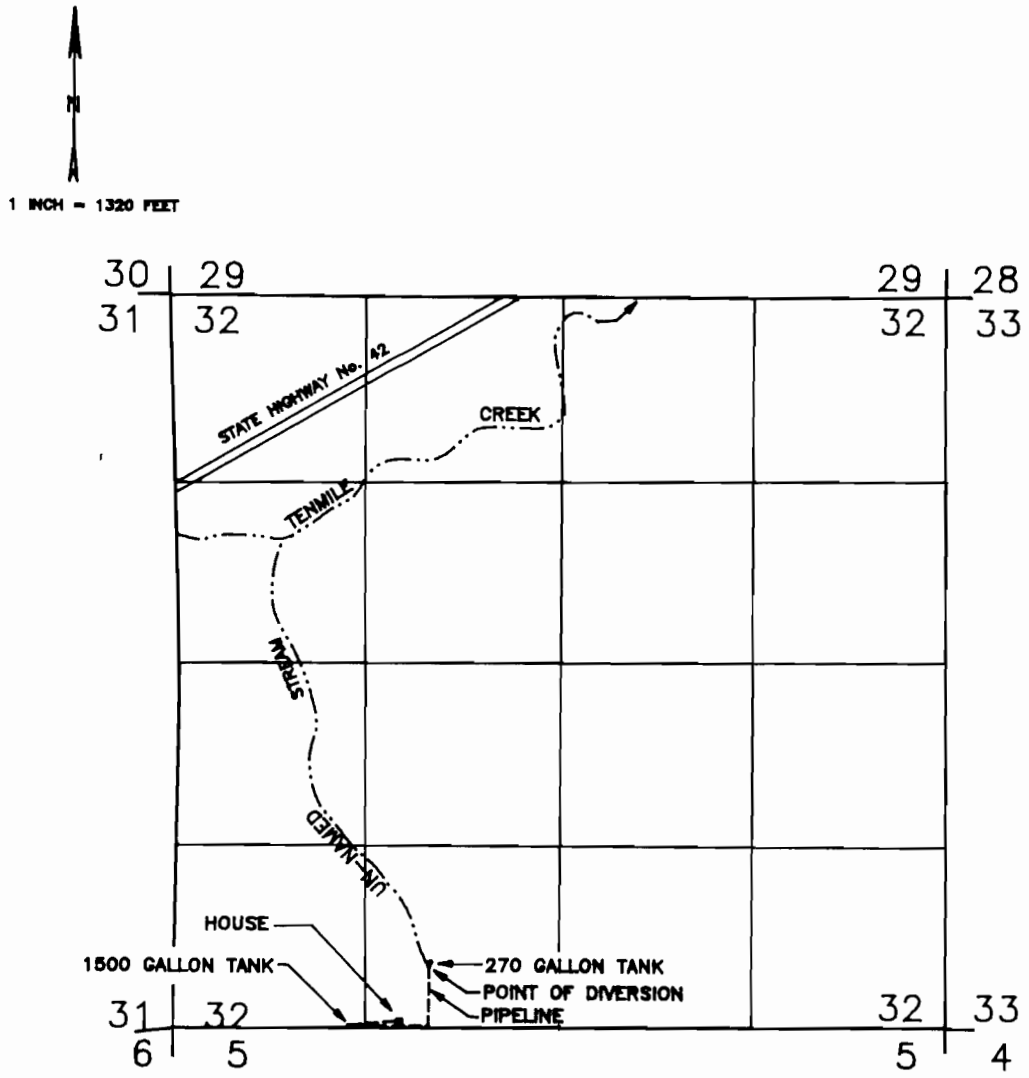

THE POINT OF DIVERSION IS LOCATED 380 FEET NORTH AND 1690 FEET EAST FROM THE SOUTHWEST CORNER OF SECTION 32, BEING WITHIN THE SE 1/4 OF THE SW 1/4 OF SECTION 32, TOWNSHIP 28 SOUTH, RANGE 7 WEST, W.M., DOUGLAS COUNTY.

THE PURPOSE OF THIS MAP IS TO IDENTIFY THE LOCATION OF THE WATER RIGHT. IT IS NOT INTENDED TO PROVIDE INFORMATION RELATIVE TO THE LOCATION OF PROPERTY OWNERSHIP BOUNDARY LINES.

RECEIVED
JAN 31 1995
WATER RESOURCES DEPT.
SALEM, OREGON

Certified Water Right Examiner
#054 WRE
James F. Gosson
Nov. 19, 1987
STATE OF OREGON