


T.24S. R.4W. W.M.

SCALE 1 INCH = 1320'

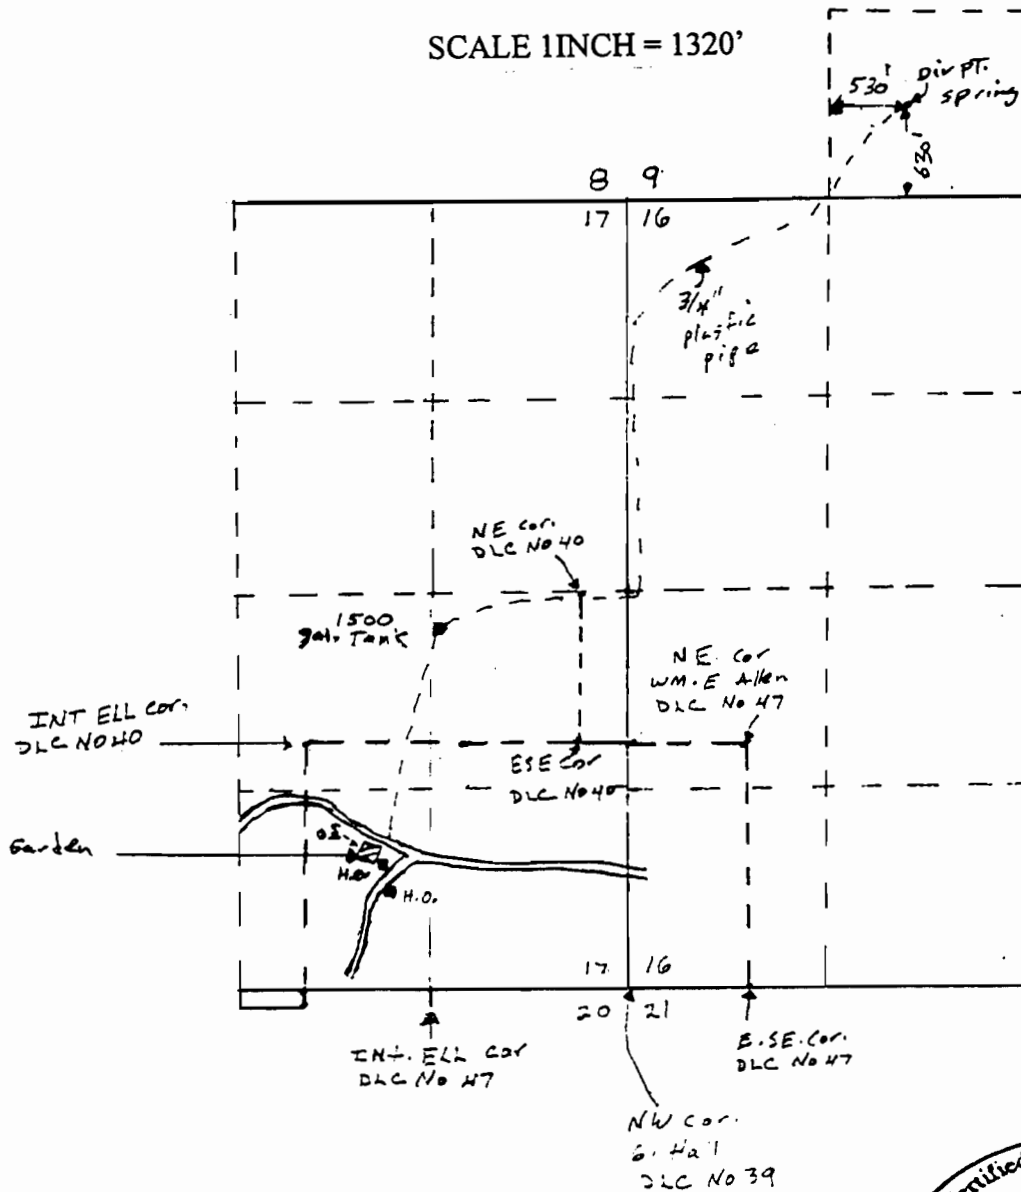


WATER RESOURCES
BUREAU

Date: 4-13-91

Point of beginning
and the referenced
Land survey/ corner
of the deed:

S.W. Cor. W.A. Allen
D.L.C. 47

THE PURPOSE OF THIS MAP IS TO
IDENTIFY THE LOCATION OF THE
WATER RIGHT. IT IS NOT INTENDED
TO PROVIDE INFORMATION RELATIVE
TO THE LOCATION OF PROPERTY
OWNERSHIP BOUNDARY LINES.

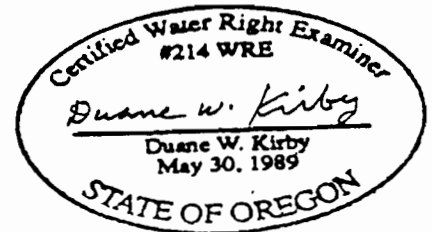

FINAL PROOF SURVEY UNDER


Application No. 71542 Permit No. 52713
IN NAME OF

EDGAR M. AND VERENE DAVIS

Surveyed MAY 25 19 97 by DUANE KIRBY

T.24S. R.4W. W.M.


SCALE 1 INCH = 1320'

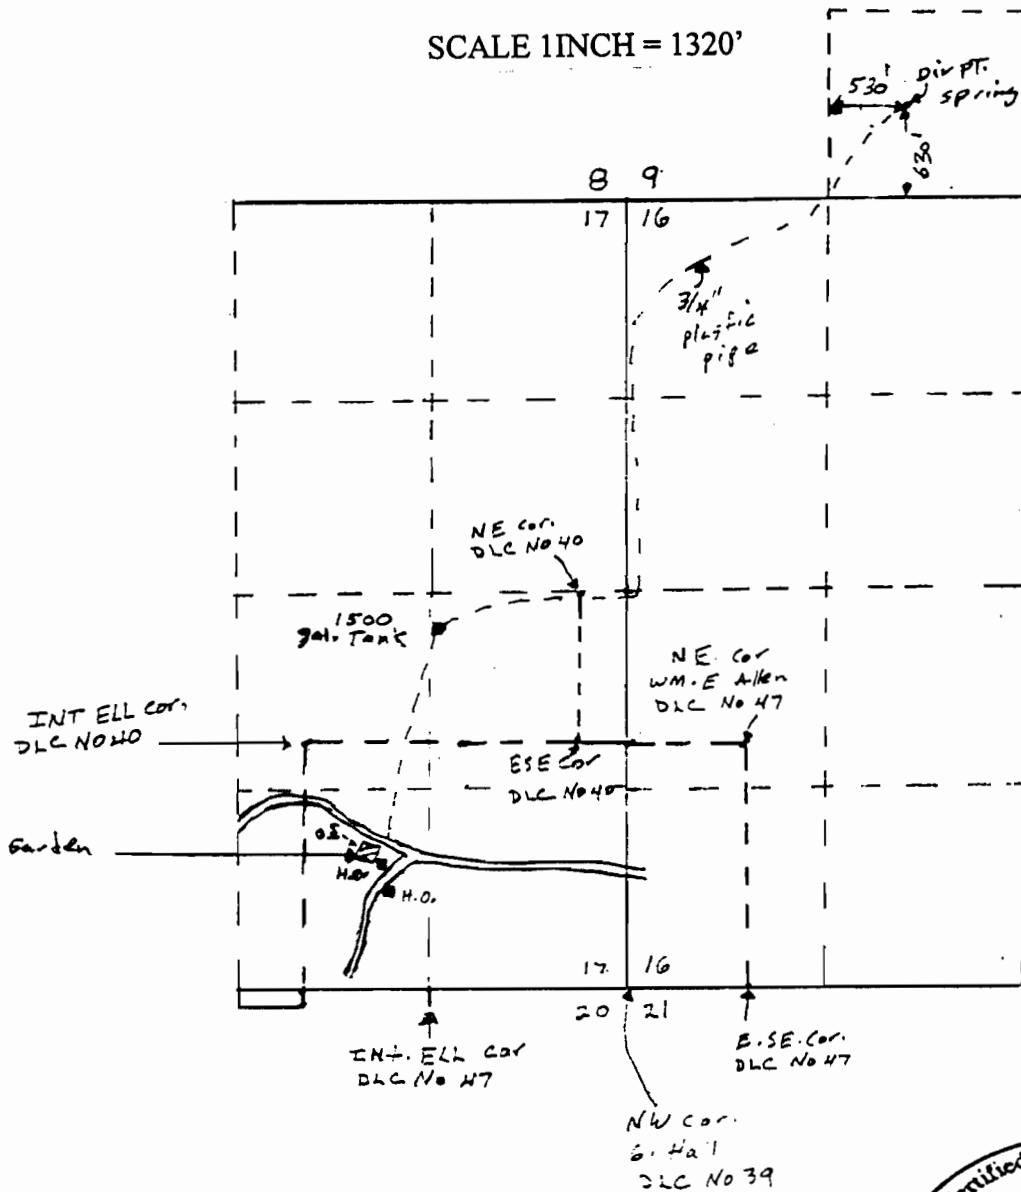

WATER RESOURCES
BUREAU

Date: 4-13-91
Point of beginning
and the referenced
Land survey corner
of the deed:
S.W. Cor. W.A. Allen
D.L.C. 47

THE PURPOSE OF THIS MAP IS TO
IDENTIFY THE LOCATION OF THE
WATER RIGHT. IT IS NOT INTENDED
TO PROVIDE INFORMATION RELATIVE
TO THE LOCATION OF PROPERTY
OWNERSHIP BOUNDARY LINES.

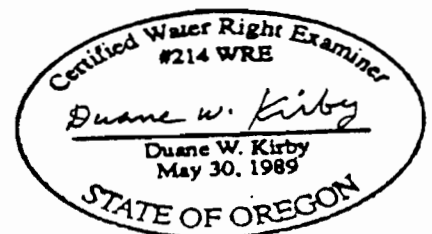

FINAL PROOF SURVEY UNDER

Application No. 71542 Permit No. 52713
IN NAME OF

EDGAR M. AND VERENE DAVIS

Surveyed MAY 25 19 97 by DUANE KIRBY