

NOV 25 1996


WATER RESOURCES DEPT.
SALEM, OREGON

21 | 22
28 | 27

T 29 S

R 5 W WM

THIS MAP IS TO BE USED
FOR WATER RIGHT PURPOSES ONLY.

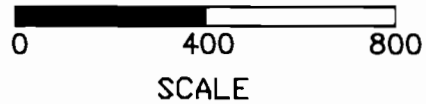

NW 1/4 NW 1/4

NE 1/4 NW 1/4


SW 1/4 NW 1/4

SE 1/4 NW 1/4

DIVERSION POINT IS 1360 FT. ^E ~~W~~ AND 2650 FT. S FROM N.W. CORNER SECTION 27

RIVERSIDE DRIVE

FINAL PROOF
SURVEY
OF PERMIT 52227
APPLICATION S-71691

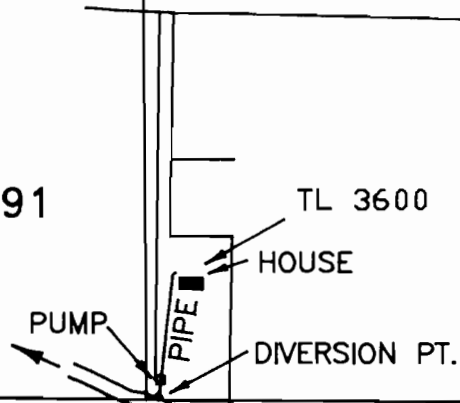

IN NAME OF

DALE & RUBY LANG

NOVEMBER 3, 1996

BY: WILLIAM J. RUPPERT
P.O. BOX 1564
MYRTLE CREEK, OR 97457



SOUTH MYRTLE CR.