

F92-13

15 14
22 23


**FINAL PROOF
WATER RIGHTS MAP**

UNDER PERMIT 52334


SE 1/4 SE 1/4, SEC. 15, T19S, R12W, W.M.
DUNES CITY, LANE COUNTY, OREGON
19-12-15-4 T.L. 200

FOR: KEN HAYES
5065 FORD WAY
FLORENCE, OREGON 97439

PREPARED BY: WOBBE & ASSOCIATES, INC.
510 KINGWOOD ST./P.O. BOX 1136
FLORENCE, OREGON 97439
JUNE 11, 1996

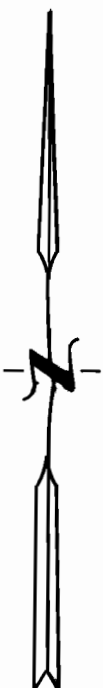

SCALE:
1" = 400'

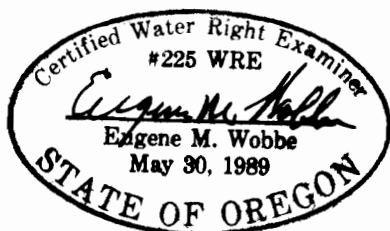

THIS MAP IS FOR THE PURPOSE OF IDENTIFYING THE LOCATION OF THE WATER RIGHT ONLY. THERE IS NO INTENT TO PROVIDE DIMENSIONS OR LOCATION OF PROPERTY OWNERSHIP LINES.