


SEC. 21, T23S, R12W WM

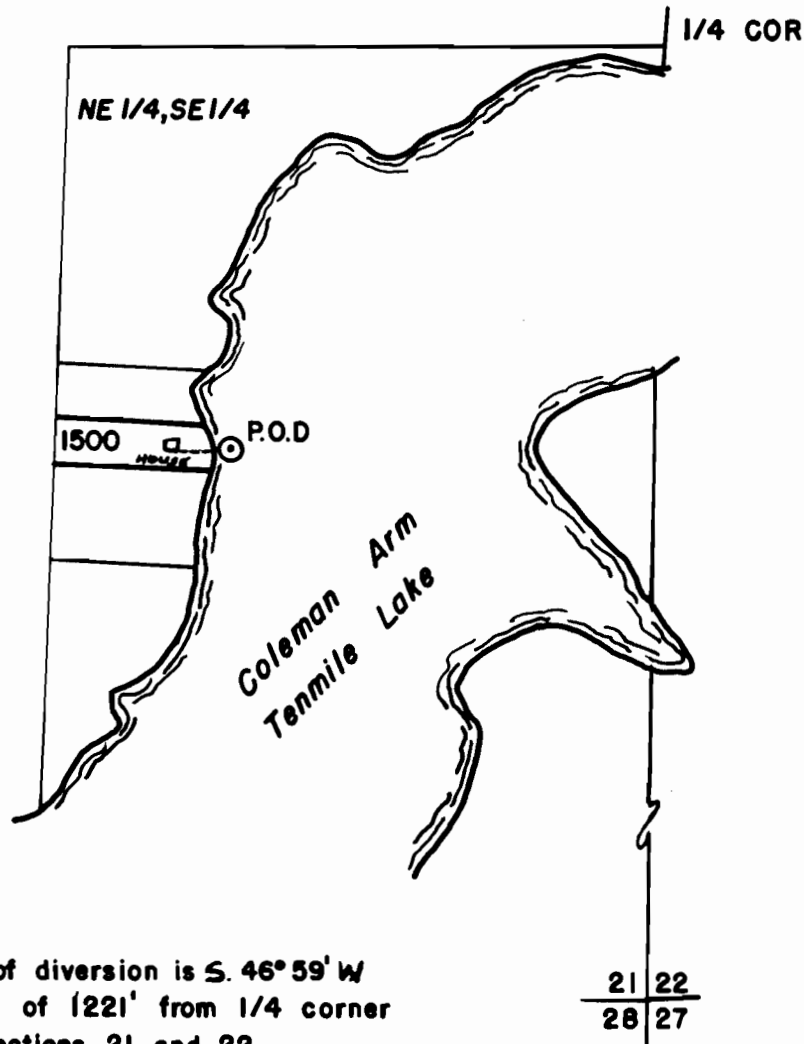

The point of diversion is S. 46° 59' W
a distance of 1221' from 1/4 corner
between sections 21 and 22.

RECEIVED
NOV 09 2001
WATER RESOURCES DEPT.
SALEM, OREGON

Scale: 1" = 400'



FINAL PROOF SURVEY UNDER

Application No. 73362 Permit No. 52110.

GLEN HOBBS

Surveyed 8-11 2000 by K. Phelps

RECEIVED

SEP 29 2000

WATER RESOURCES DEPT.
SALEM, OREGON