

FINAL PROOF SURVEY MAP


Portions of the NE1/4 of the NW1/4

Section 21 Township 23S Range 12W W.M.

Coos County

S15 S16
S22 S21

S16 1/4
S21

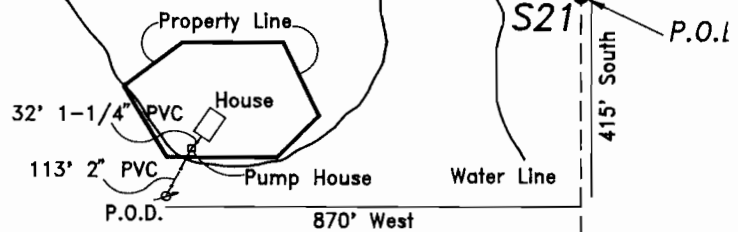

Ten Mile Lake

NOTE:

The P.O.D. is an in-lake 1/2 HP submersible pump located 415' South and 870' West of the N 1/4 corner of Section 21. The P.O.B. is the N 1/4 corner of Section 21.

NW1/4, NW1/4

NE1/4, NW1/4

Prepared For: Gloria Golder
Prepared By: Dennis Goude
Date Prepared: August 9, 1996

LEGEND

P.O.B.

P.O.D.

PIPE

NOTE:


The P.O.D. and Waterline is entirely located on property owned by the applicant.

SW1/4, NW1/4

SE1/4, NW1/4

C1/4

Scale 1" = 400 Feet

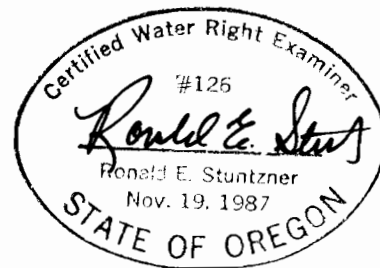

EXAMINERS DISCLAIMER STATEMENT

The preparation of this map was for the purpose of identifying the location of the Water Right only and has no intent to provide dimensions or location of property ownership lines.

RECEIVED

SEP 03 1996

WATER RESOURCES DEPT
SALEM, OREGON

Stuntzner Engineering
& Forestry

705 So. 4th Street
P.O. Box 118
Coos Bay, Oregon 97420

Phone (541) 267-2872
Fax (541) 267-0588

Application No. S-74079

Permit No. 52512