


Tax Lot TL1300 Tax Account No. 341.00
Section 21 Township 23S Range 12W W.M.
Coos County **RECEIVED**

JAN - 7 1997

WATER RESOURCES DE
SALEM, OREGON

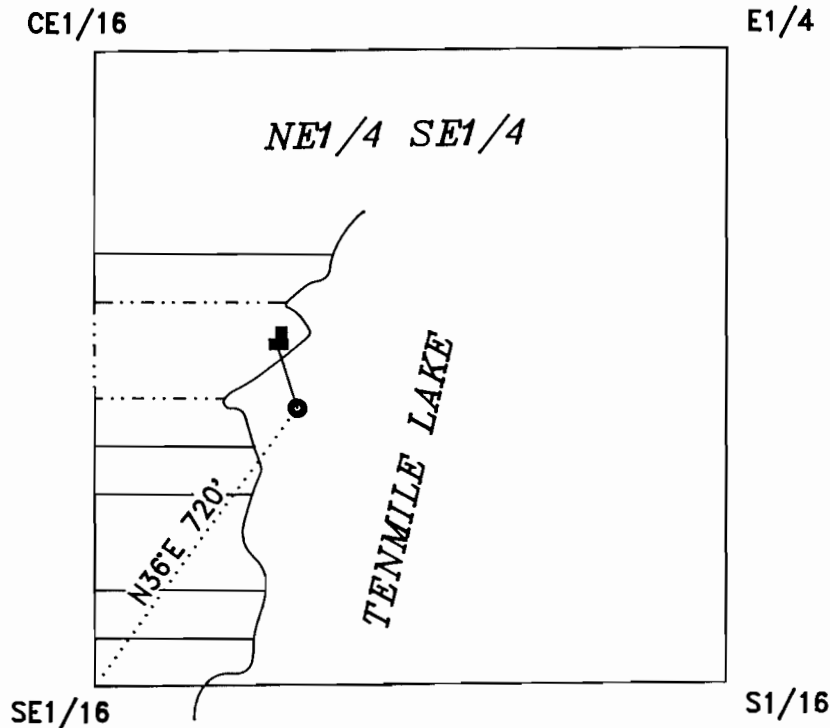


Legend

- P.O.D.
- Property Line
- Waterline
- House

EXAMINERS DISCLAIMER STATEMENT

The preparation of this map was for the purpose of identifying the location of the Water Right only and has no intent to provide dimensions or location of property ownership lines.

FINAL PROOF SURVEY
IN THE NAME OF
Carter Boehm

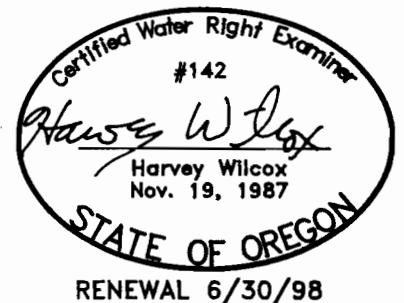

Surveyed on 12/2/96 by H.A. Wilcox

Application No. S-80626
Permit No. 52667