


Tax Lot No. 23 12 17B 1700
Section 17 Township 23S Range 12W W.M.
Coos County

RECEIVED

MAY 14 1997

WATER RESOURCES DEPT
SALES OREGON

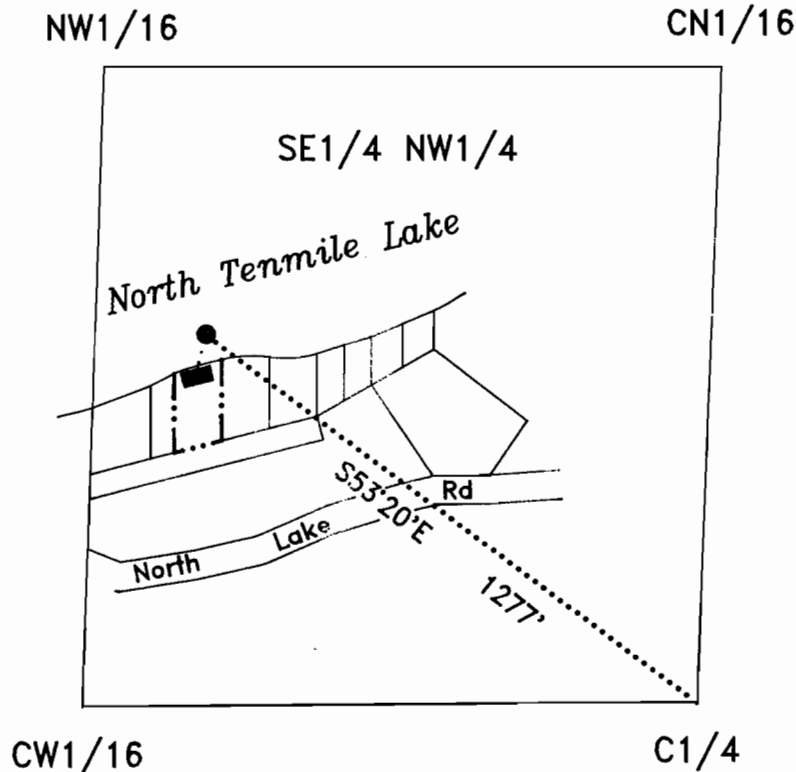


Legend

- P.O.D.
- Property Line
- Waterline
- House

EXAMINERS DISCLAIMER STATEMENT

The preparation of this map was for the purpose of identifying the location of the Water Right only and has no intent to provide dimensions or location of property ownership lines.

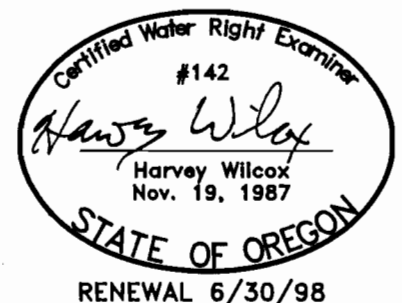

FINAL PROOF SURVEY
IN THE NAME OF
David G. Hanson

Surveyed on 4/23/97 by H.A. Wilcox

Application No. S-80934
Permit No. 52959