


Tax Lot No. TL1000 23 12 10BB
Section 10 Township 23 Range 12 W.M.
Coos County

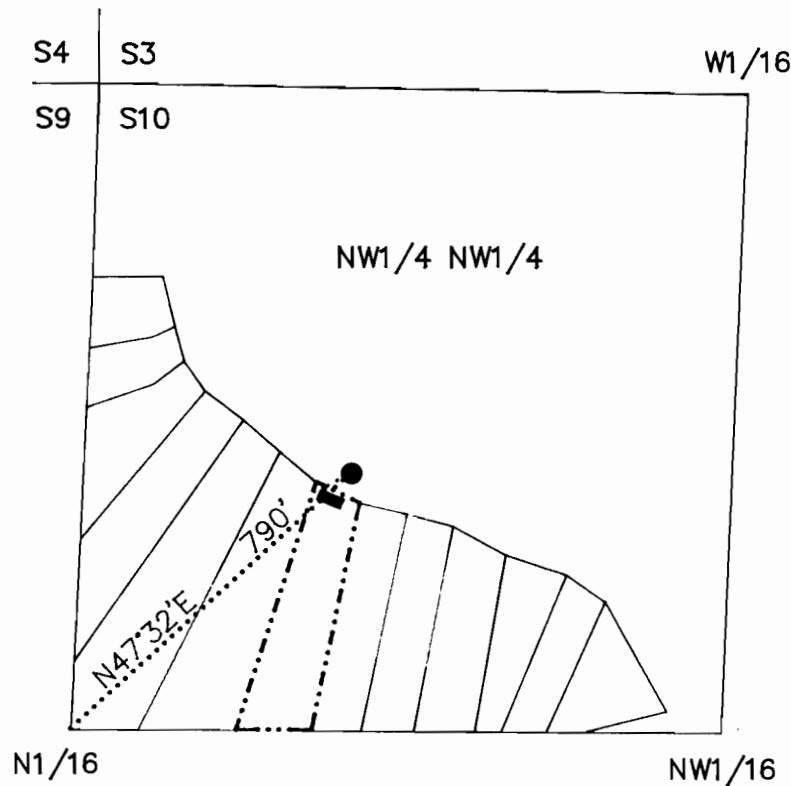

Scale 1" = 400'

LEGEND

- HOME
- POINT OF DIVERSION
- PUMP HOUSE
- WATERLINE
- PROPERTY LINE

EXAMINERS DISCLAIMER STATEMENT


The preparation of this map was for the purpose of identifying the location of the Water Right only and has no intent to provide dimensions or location of property ownership lines.

FINAL PROOF SURVEY
IN THE NAME OF
Melba E. Holmgreen

RECEIVED

SEP 24 2001

WATER RESOURCES DEPT.
SALEM, OREGON

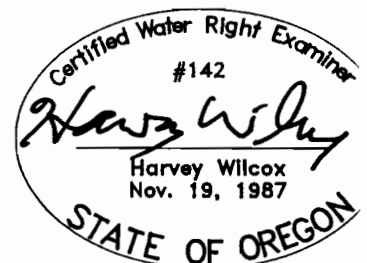

RENEWAL 6/30/02

Surveyed on 9/7/01 by H.A. Wilcox

Application No. S-80915
Permit No. 53025