


Tax Lot No. TL1300 23 12 19D

Section 19 Township 23S Range 12W W.M.

Coos County

C1/4

E1/4

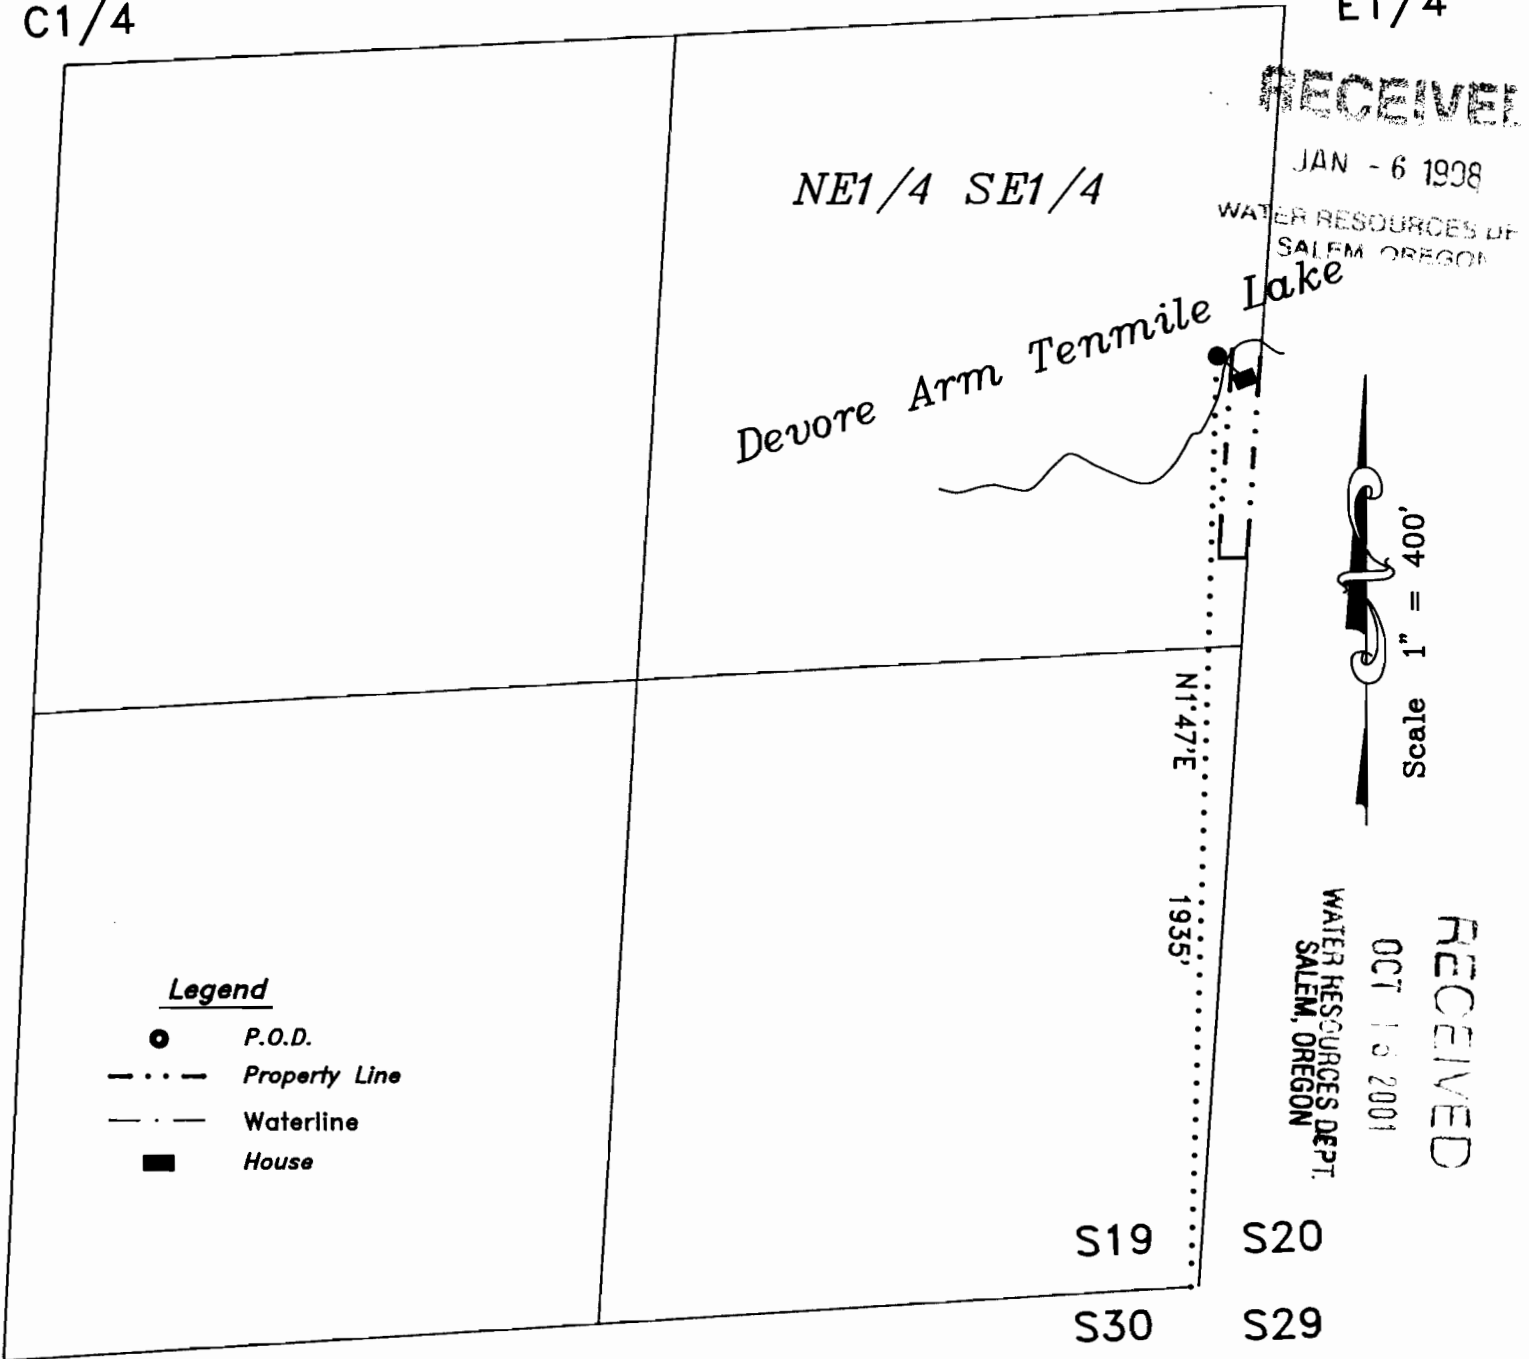

**Legend**

- P.O.D.
- . . - Property Line
- - - Waterline
- House

**EXAMINERS DISCLAIMER STATEMENT**


The preparation of this map was for the purpose of identifying the location of the Water Right only and has no intent to provide dimensions or location of property ownership lines.

S1/4

**FINAL PROOF SURVEY**

IN THE NAME OF

Irene M. Opland

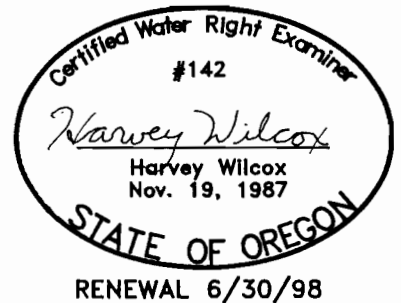

Surveyed on 11/13/97 by H.A. Wilcox

Application No. S-80927  
Permit No. 52984