


Tax Lot TL300 Tax Account No. 234.03
Section 17 Township 23S Range 12W W.M.
Coos County

RECEIVED

FEB - 6 1997

WATER RESOURCES DEPT.
SALEM, OREGON

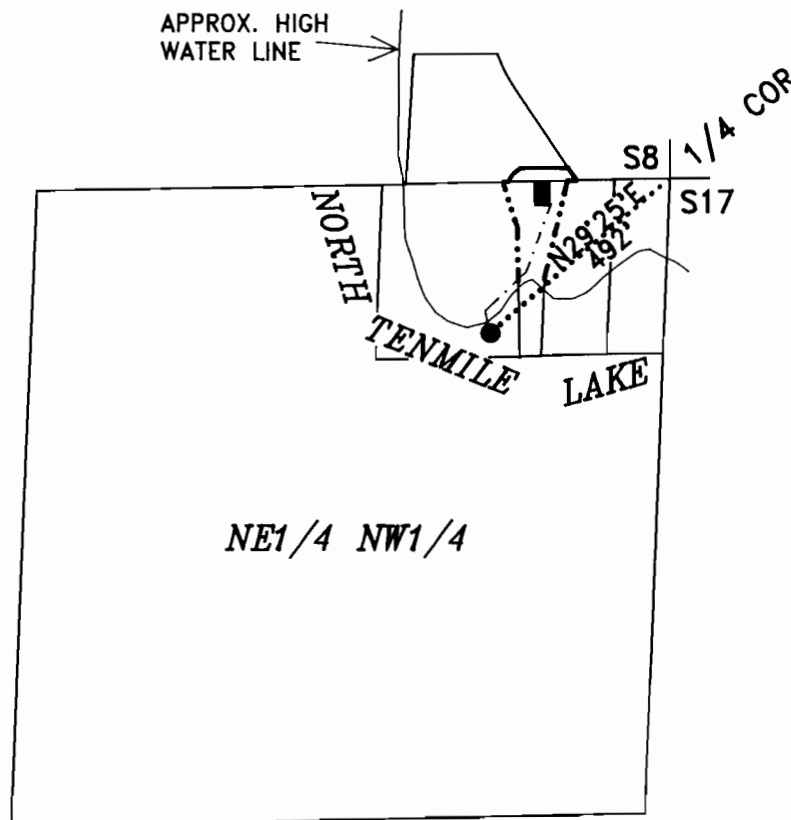


Legend

- P.O.D.
- - - - - Property Line
- - - - - Waterline
- House

EXAMINERS DISCLAIMER STATEMENT

The preparation of this map was for the purpose of identifying the location of the Water Right only and has no intent to provide dimensions or location of property ownership lines.

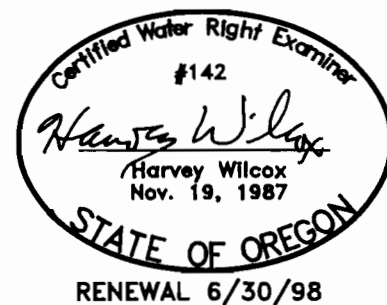

FINAL PROOF SURVEY
IN THE NAME OF
Shirley J. Titus

Surveyed on 11/26/96 by H.A. Wilcox

Application No. S-80946
Permit No. 53017