


FINAL PROOF SURVEY
Located in portions of the SW 1/4 NW 1/4 of
Section 21, Township 23 South, Range 12 West, W.M.
Coos County, Oregon
App. # S-80951, Permit #52965


RECEIVED

MAR 19 1997
WATER RESOURCES DEPT.
SALEM, OREGON

Scale
1"=400'

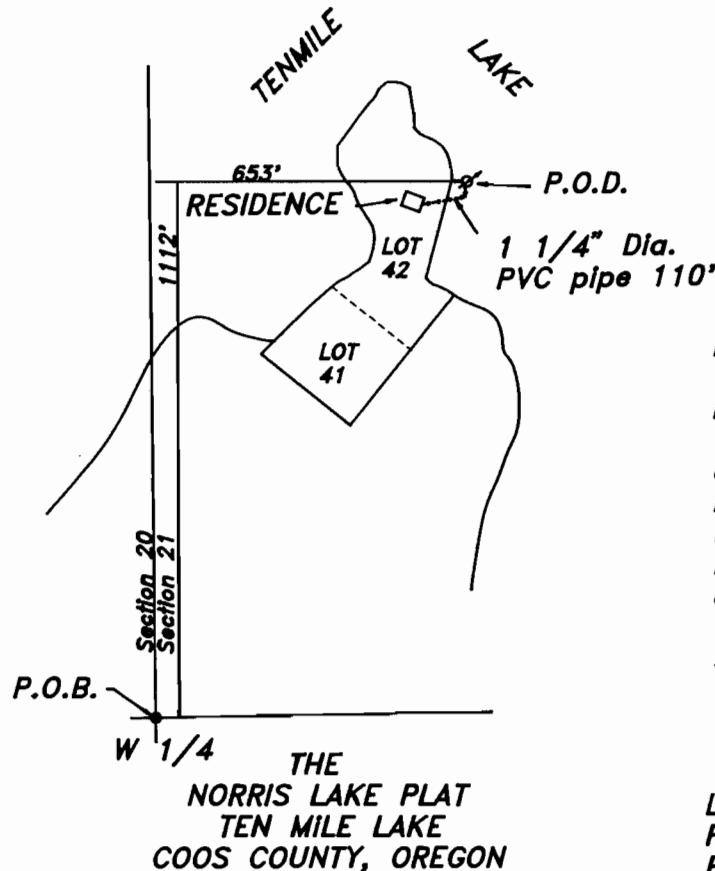

Note:
The P.O.D. is a 1/2 horsepower Dayton pump with 110 feet of 1 1/4" diameter PVC pipe connecting to the place of use. The P.O.D. is located 653 feet east and 1112 feet north of the west 1/4 corner of Section 21.

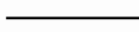Legend
P.O.B. 
P.O.D. 
PIPE 
PROPERTY 
LINE 

Prepared For: Stan & Nian Porter
Prepared By: Dennis Goude
Surveyed: Aug. 6, 1996



EXPIRES 06/30/98

**Stuntzner Engineering
& Forestry, LLC**

ENGINEERING * LAND SURVEYING * FORESTRY
PLANNING * WATER RIGHTS

705 South 4th St.
Post Office Box 118
Coos Bay, Oregon 97409

Phone (541) 267-2872
Fax (541) 267-0508

WATER EXAMINER'S STATEMENT

The preparation of this map was for the purpose of identifying the location of the Water Right only and has no intent to provide dimensions or location of property ownership lines.