


Tax Lot 23 12 8CD TL500

Section 8 Township 23S Range 12W W.M.
Coos County

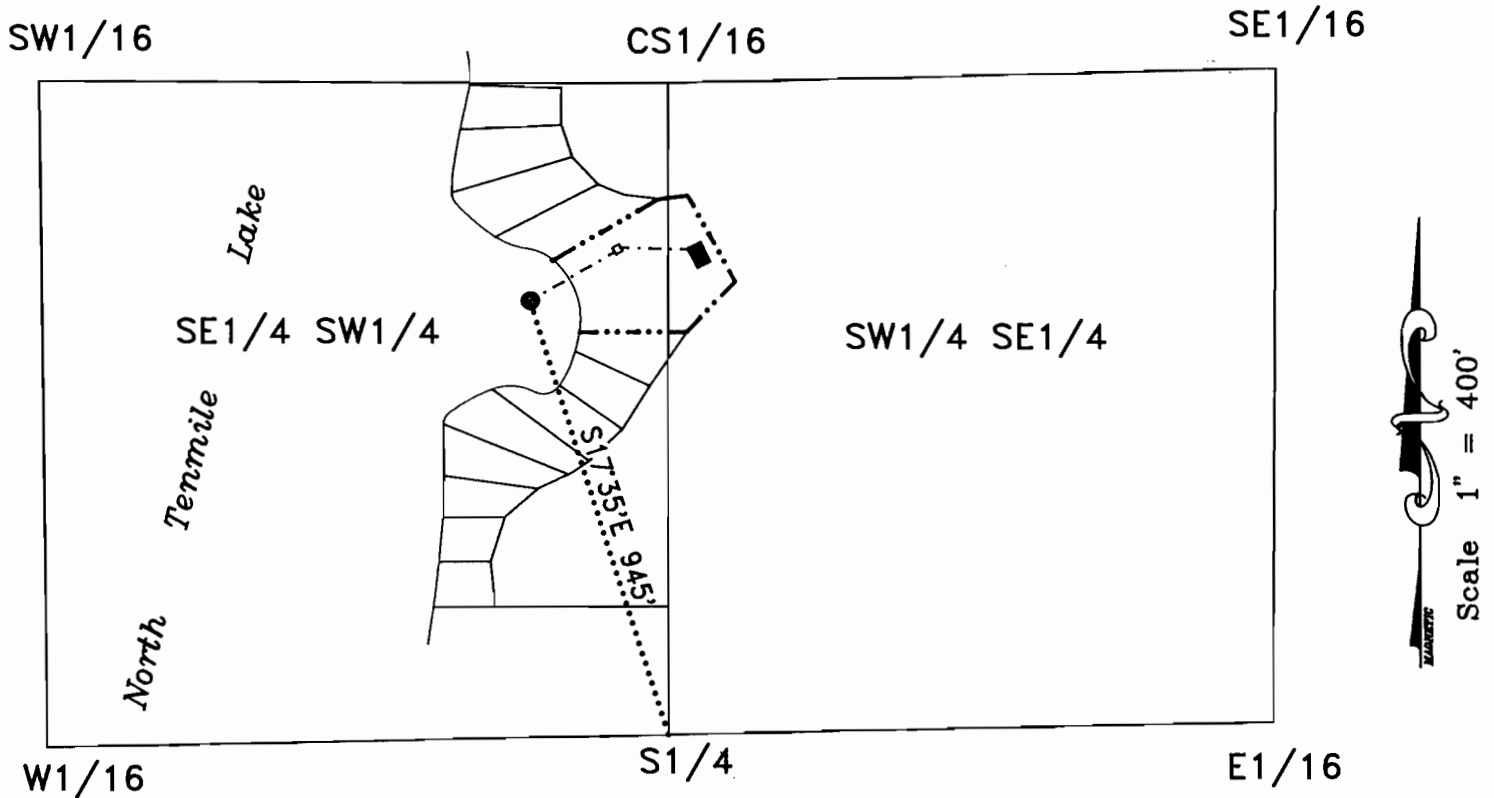

Legend

- P.O.D.
- Property Line
- Waterline
- House
- Pump House


EXAMINERS DISCLAIMER STATEMENT

The preparation of this map was for the purpose of identifying the location of the Water Right only and has no intent to provide dimensions or location of property ownership lines.

FINAL PROOF SURVEY
IN THE NAME OF
Michael C. Wilkins

Surveyed on 5/12/97 by H.A. Wilcox

JUN - 4 1997
WATER RESOURCES DEPT.
SALEM, OREGON

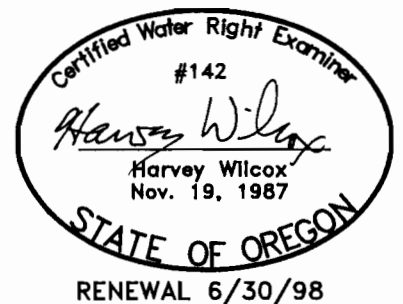

Application No. S-81069
Permit No. 53076