

Tax Lot No. TL2400 23 12 22B  
Section 22 Township 23S Range 12W W.M.  
Coos County


S16 S15  
S21 S22

LEGEND

- HOME
- POINT OF DIVERSION
- WATERLINE
- - - - - PROPERTY LINE


EXAMINERS DISCLAIMER STATEMENT

The preparation of this map was for the purpose of identifying the location of the Water Right only and has no intent to provide dimensions or location of property ownership lines.

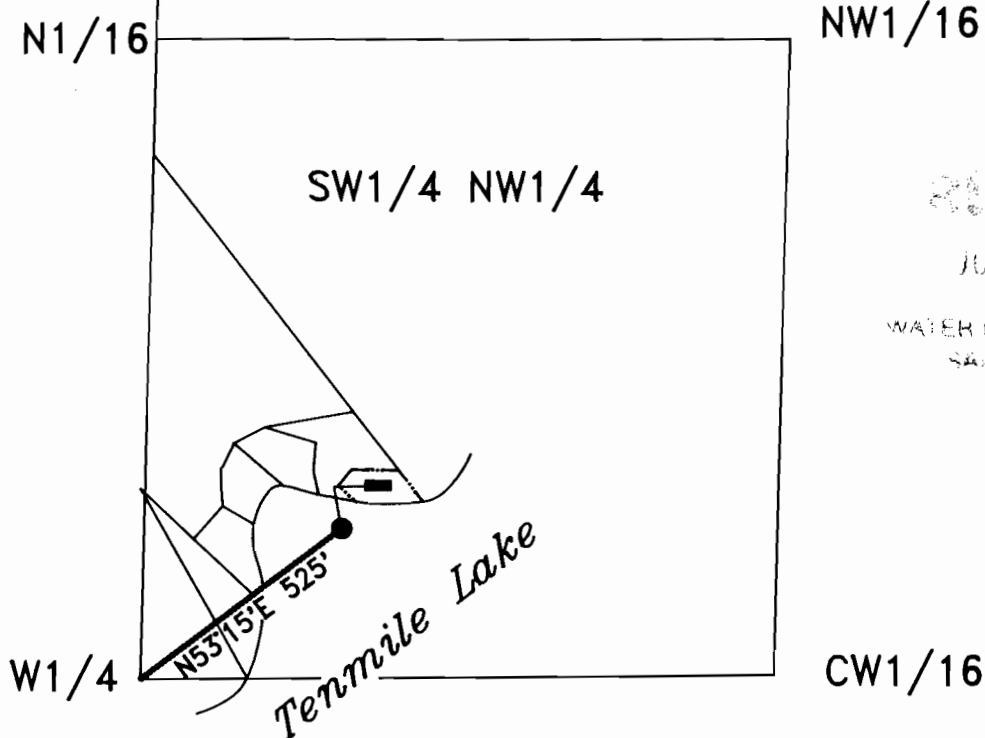

RECEIVED  
JUN 25 1996  
WATER RESOURCES DEPT.  
SALEM, OREGON

**FINAL PROOF SURVEY**  
IN THE NAME OF  
Gene & Teresa Moritz

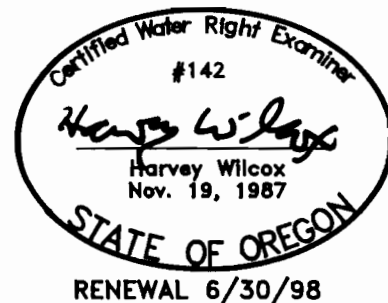

RENEWAL 6/30/98

Surveyed on 4/23/98 by H.A. Wilcox

Application No. S-81104  
Permit No. 53075