


Tax Lot No. 23 12 29BA TL1200
 Section 29 Township 23S Range 12W W.M.
 Coos County

RECEIVED

SEP - 2 1997

WATER RESOURCES DEPT.
 941 EM. OREGON

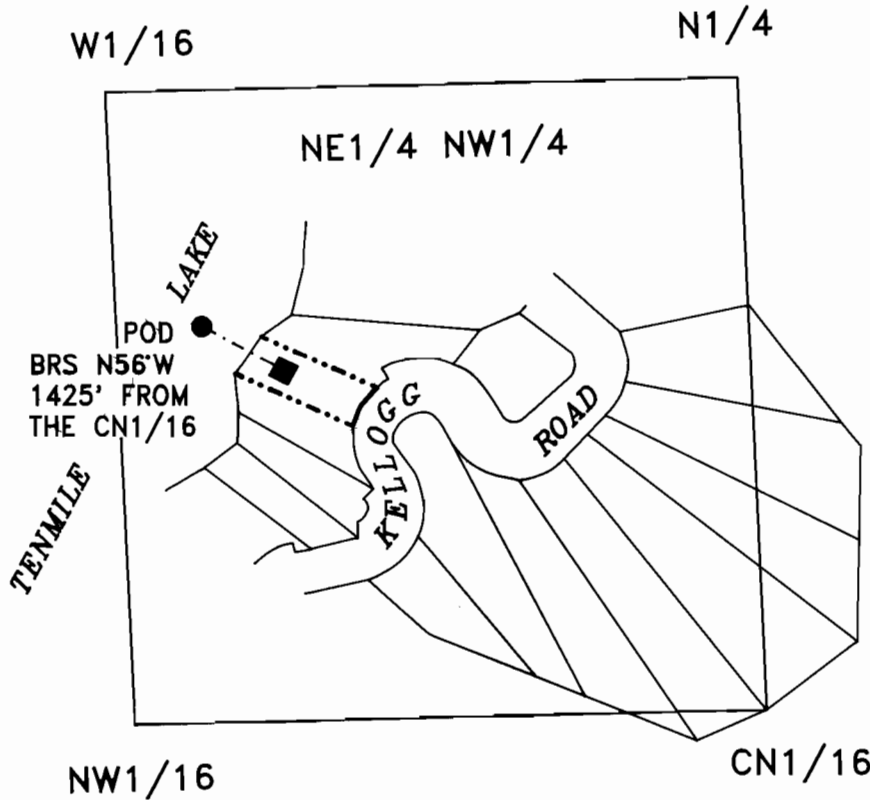


Legend

- P.O.D.
- - - - - Property Line
- · · · · Waterline
- House

EXAMINERS DISCLAIMER STATEMENT

The preparation of this map was for the purpose of identifying the location of the Water Right only and has no intent to provide dimensions or location of property ownership lines.

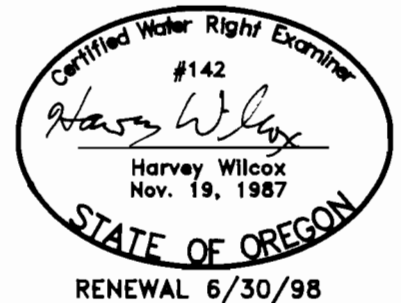

FINAL PROOF SURVEY
 IN THE NAME OF
Robert Lund

Surveyed on 7/17/97 by H.A. Wilcox

Application No. S-81373
 Permit No. 53132