


Tax Lot No. 1400 23 12 22C


Section 22 Township 23 Range 12 W.M.

Coos County

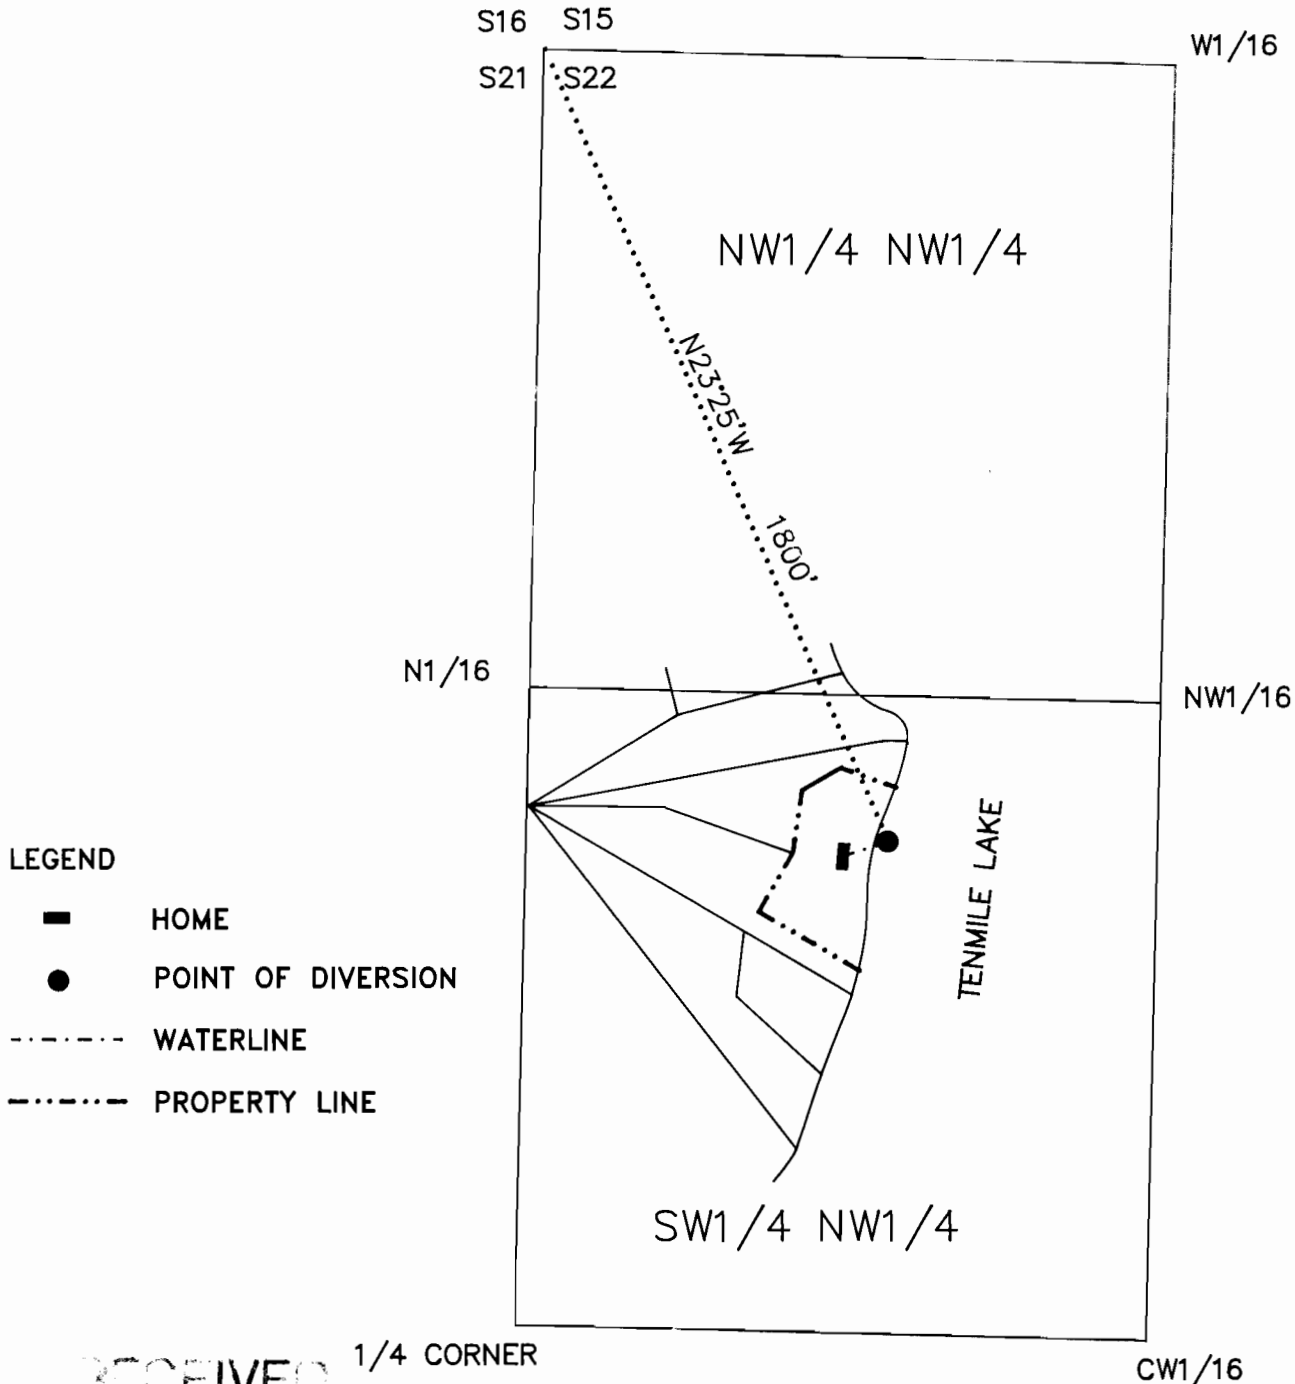

EXAMINERS DISCLAIMER STATEMENT

The preparation of this map was for the purpose of identifying the location of the Water Right only and has no intent to provide dimensions or location of property ownership lines.

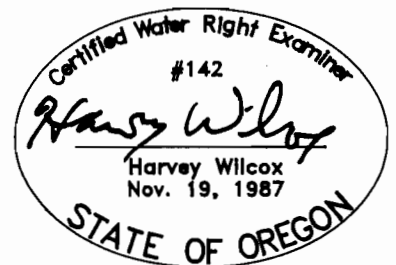

RENEWAL 6/30/02

FINAL PROOF SURVEY
IN THE NAME OF
C. RICHARD & CECILIA D. LATTIN

Surveyed on 5/11/00 by H.A. Wilcox

Application No. S-81405

Permit No. 53177