


Tax Lot No. TL400&TL500 23 12 9BB
Section 9 Township 23S Range 12W W.M.
Coos County

Scale 1" = 400'

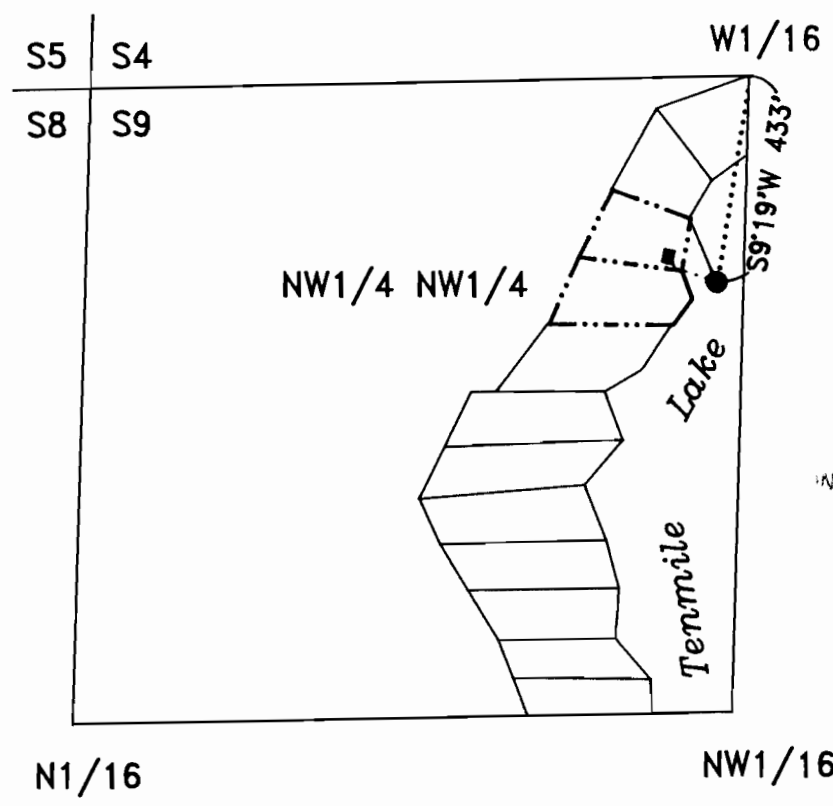

RECEIVED

APR 28 1999

WATER RIGHT DIVISION
SALE OF PERMIT

- LEGEND
- HOME
 - POINT OF DIVERSION
 - WATERLINE
 - PROPERTY LINE

EXAMINERS DISCLAIMER STATEMENT

The preparation of this map was for the purpose of identifying the location of the Water Right only and has no intent to provide dimensions or location of property ownership lines.

FINAL PROOF SURVEY
IN THE NAME OF
Michael Pearson

Surveyed on 4/7/99 by H.A. Wilcox

Certified Water Right Examiner
#142
Harvey Wilcox
Harvey Wilcox
Nov. 19, 1987
STATE OF OREGON
RENEWAL 6/30/00

Application No. S-81480
Permit No. 53129