


Tax Lot No. TL400 23 12 17DB
Section 17 Township 23S Range 12W W.M.
Coos County

RECEIVED

FEB 23 1998

WATER RESOURCES DEPT.
SALEM, OREGON

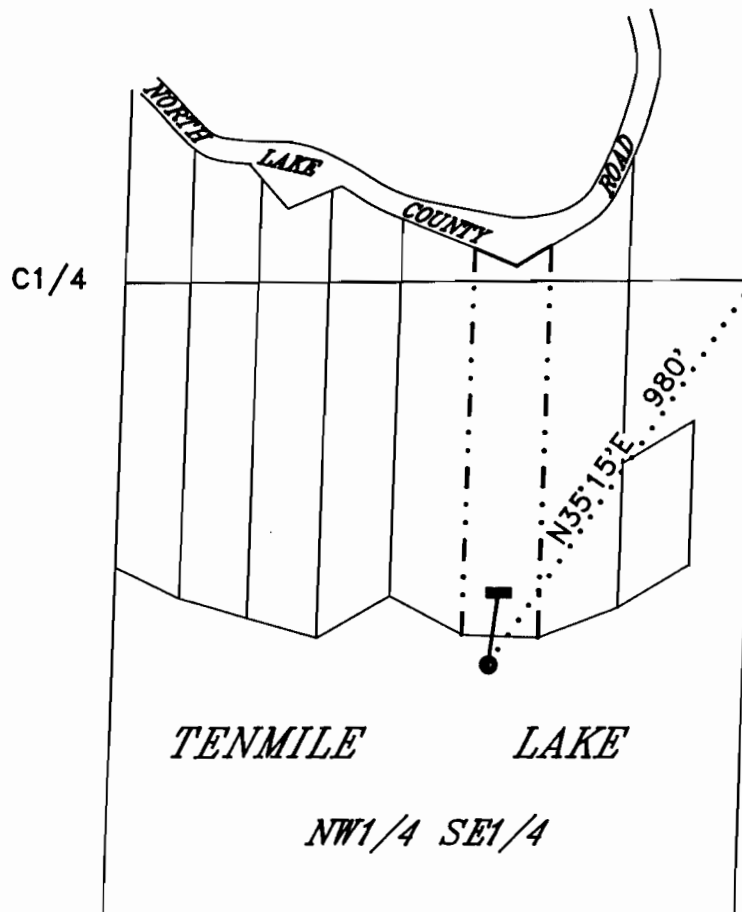


Scale 1" = 400'

Legend

- P.O.D.
- . . - Property Line
- Waterline
- House

EXAMINERS DISCLAIMER STATEMENT

The preparation of this map was for the purpose of identifying the location of the Water Right only and has no intent to provide dimensions or location of property ownership lines.

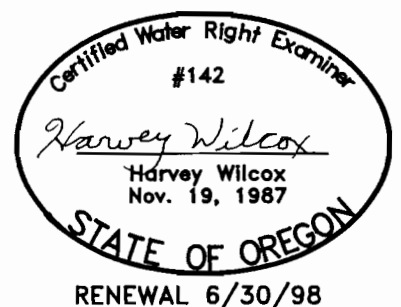

FINAL PROOF SURVEY
IN THE NAME OF
Diann Roe

Surveyed on 12/19/97 by H.A. Wilcox

Application No. 5-81558
Permit No. 53191