

CLAIM OF BENEFICIAL USE FINAL PROOF MAP

Located in the SW $\frac{1}{4}$ SW $\frac{1}{4}$ of Section 9,
Township 23 South, Range 12 West, W.M.
Coos County, Oregon
Application S-81595 Permit S-53383


RECEIVED
FEB 02 1999

WATER RESOURCES DEPT.
SALEM, OREGON

Scale 1" = 100 Feet
Assessors Scale

P.O.B. $\nearrow$ 30'
SW 1/16
Corner
Section 9

Prepared For: Franklin M. & Patricia E. Gray
Prepared By: Dennis Goude
Date Prepared: January 12, 1999

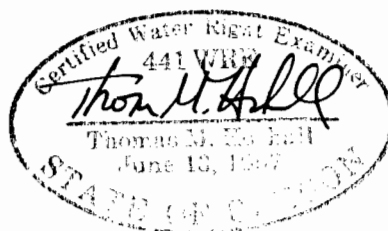

EXPIRES 06/30/99

LEGEND
P.O.B. 
P.O.D. 
PIPE 

NOTE:
The P.O.D. is an intake
submersible $\frac{1}{2}$ HP pump
located 30 feet west and
625 feet south from the
SW 1/16 corner of Sec.
9.

EXAMINERS DISCLAIMER STATEMENT

The preparation of this map was for the purpose of
identifying the location of the Water Right only and
has no intent to provide dimensions or location of
property ownership lines.

Stuntzner Engineering
& Forestry, L.L.C.

ENGINEERING • LAND SURVEYING • FORESTRY
PLANNING • WATER RIGHTS

705 South 4th St.
Post Office Box 118
Coos Bay, Oregon 97420

Phone: (541) 267-2872
Fax: (541) 267-0588