


Tax Lot No. TL300 23 12 9BB

Section 9 Township 23S Range 12W W.M.
Coos County

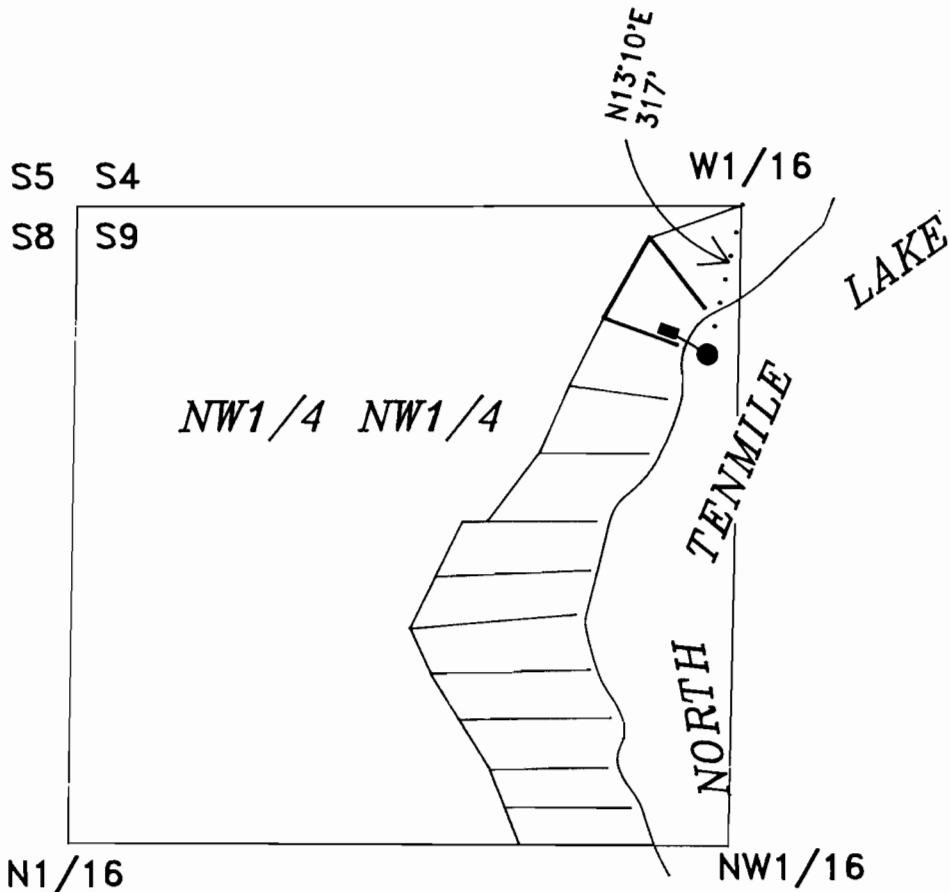

LEGEND

- HOME
- POINT OF DIVERSION
- · — WATERLINE
- · · - PROPERTY LINE

EXAMINERS DISCLAIMER STATEMENT


The preparation of this map was for the purpose of identifying the location of the Water Right only and has no intent to provide dimensions or location of property ownership lines.

RECEIVED

NOV 05 2001

WATER RESOURCES DEPT.
SALEM, OREGON

FINAL PROOF SURVEY
IN THE NAME OF
Scott Weninger & James Nowlin

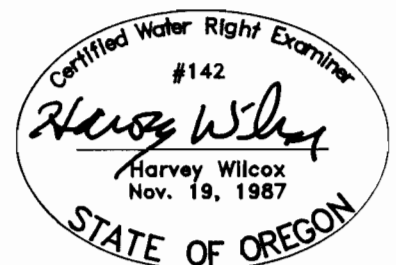

RENEWAL 6/30/00

Surveyed on 6/6/98 by H.A. Wilcox

Application No. S-81596
Permit No. 53227