


Tax Lot No. TL800 23 12 5AA
Section 5 Township 23S Range 12W W.M.
Coos County

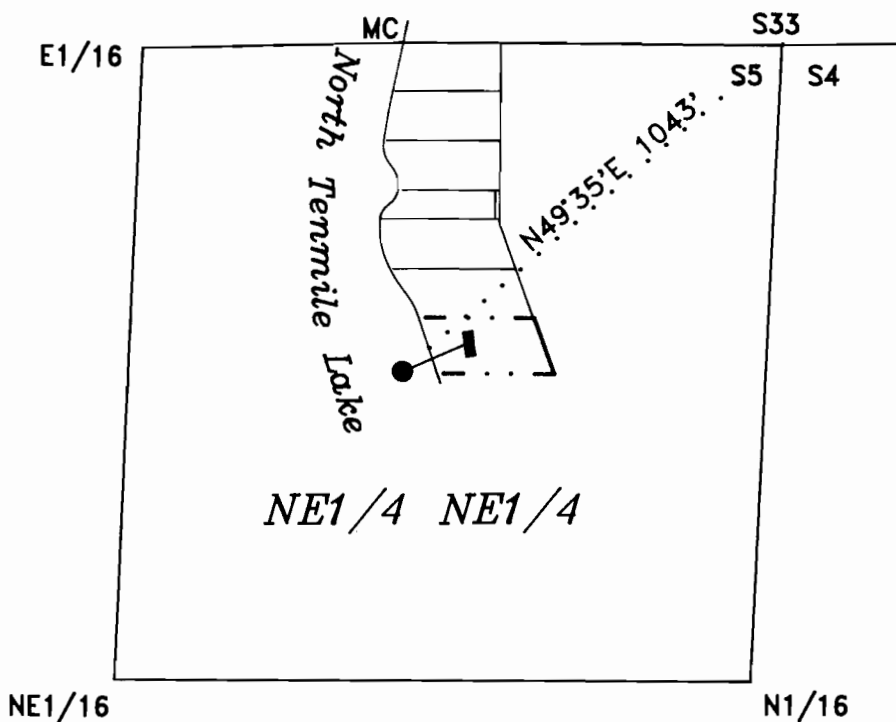

LEGEND

- HOME
- POINT OF DIVERSION
- . - WATERLINE
- . . - PROPERTY LINE

BASIS OF BEARINGS FROM THE PLAT OF BLACK CREEK PARK

EXAMINERS DISCLAIMER STATEMENT

The preparation of this map was for the purpose of identifying the location of the Water Right only and has no intent to provide dimensions or location of property ownership lines.

FINAL PROOF SURVEY
IN THE NAME OF
Robert Blancke

Surveyed on 5/11/98 by H.A. Wilcox

RECEIVED

NOV 05 2001

WATER RESOURCES DEPT
SALEM, OREGON



Application No. S-81599
Permit No. 53315