


Tax Lot No. TL400 23 12 21
Section 21 Township 23S Range 12W W.M.
Coos County

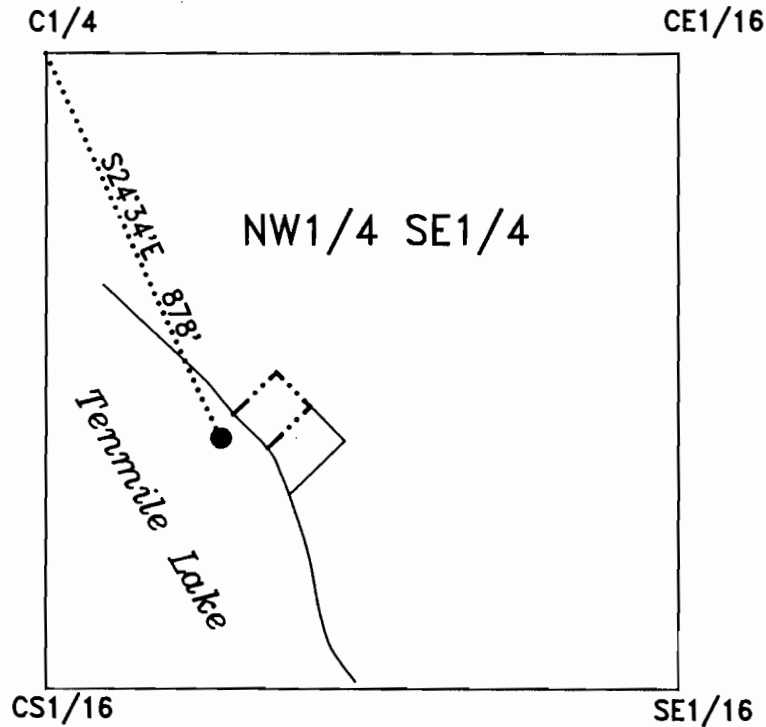

LEGEND

● POINT OF DIVERSION
AND FLOATING HOME

----- PROPERTY LINE

EXAMINERS DISCLAIMER STATEMENT

The preparation of this map was for the purpose of identifying the location of the Water Right only and has no intent to provide dimensions or location of property ownership lines.

FINAL PROOF SURVEY

IN THE NAME OF


Richard and Susan Weinhold

Surveyed on 5/1/99 by H.A. Wilcox

RECEIVED

MAY 13 1999

WATER RESOURCES DEPT
SALEM, OREGON

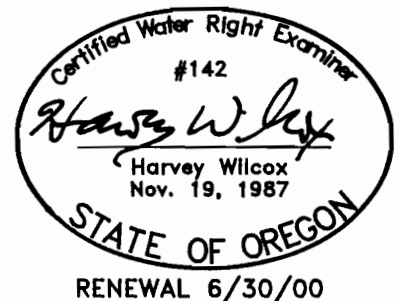

Application No. S-81655

Permit No. 53292