

Tax Lot TL900 23 12 8CD
Section 8 Township 23S Range 12W W.M.
Coos County


RECEIVED

DEC 04 1998

WATER RESOURCES DEPT.
SALEM, OREGON

SW1/16

CS1/16

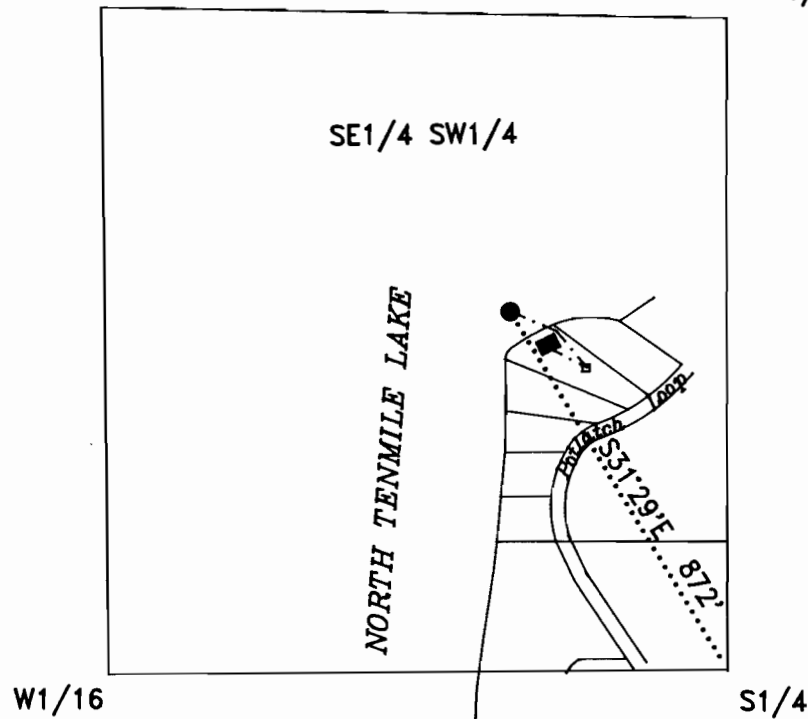

Scale 1" = 400'


Legend

- P.O.D.
- Property Line
- Waterline
- House

EXAMINERS DISCLAIMER STATEMENT

The preparation of this map was for the purpose of identifying the location of the Water Right only and has no intent to provide dimensions or location of property ownership lines.

FINAL PROOF SURVEY
IN THE NAME OF
Earle and Lela Munion

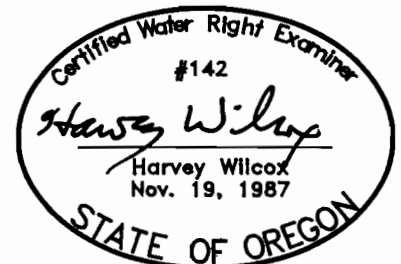

RENEWAL 6/30/00

Surveyed on 11/6/98 by H.A. Wilcox

Application No. S-81657
Permit No. 53330