


Tax Lot No. TL300 23 12 21DC
Section 21 Township 23S Range 12W W.M.
Coos County

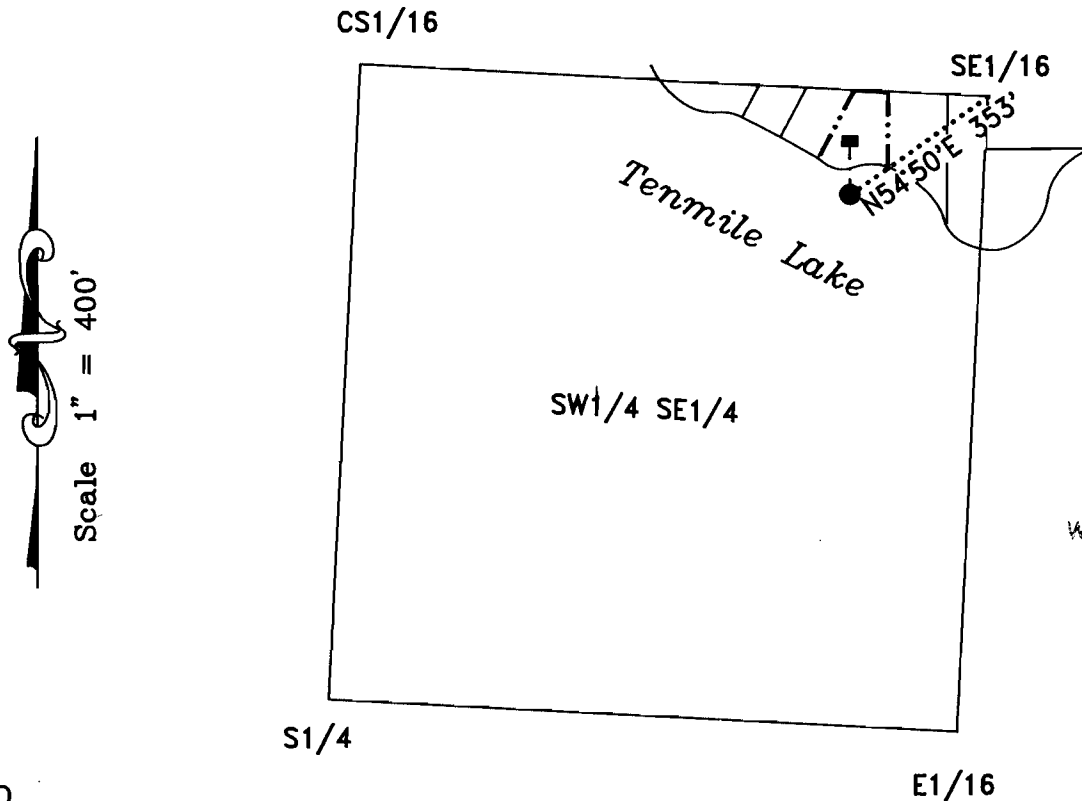

RECEIVED

OCT 14 1998

WATER RESOURCES DEPT.
SALEM, OREGON

LEGEND

- HOME
- POINT OF DIVERSION
- WATERLINE
- PROPERTY LINE

EXAMINERS DISCLAIMER STATEMENT


The preparation of this map was for the purpose of identifying the location of the Water Right only and has no intent to provide dimensions or location of property ownership lines.

FINAL PROOF SURVEY

IN THE NAME OF

John & Delores Sullivan

Surveyed on 8/25/98 by H.A. Wilcox

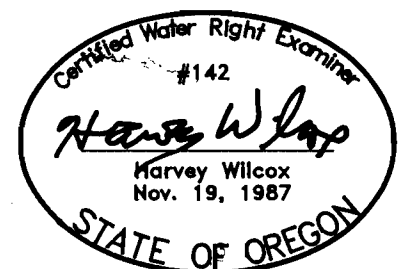

RENEWAL 6/30/00

Application No. S-81731
Permit No. 53286