

Tax Lot No, TL1400 23 12 9 ^{ADP 10/16/01}
Section 9 Township 23S Range 12W W.M.
Coos County

NW1/16

CN1/16


RECEIVED

MAY 17 1999

WATER RESOURCES DEPT
SALEM, OREGON

Legend

- P.O.D.
- - - - - Property Line
- - - - - Waterline
- House

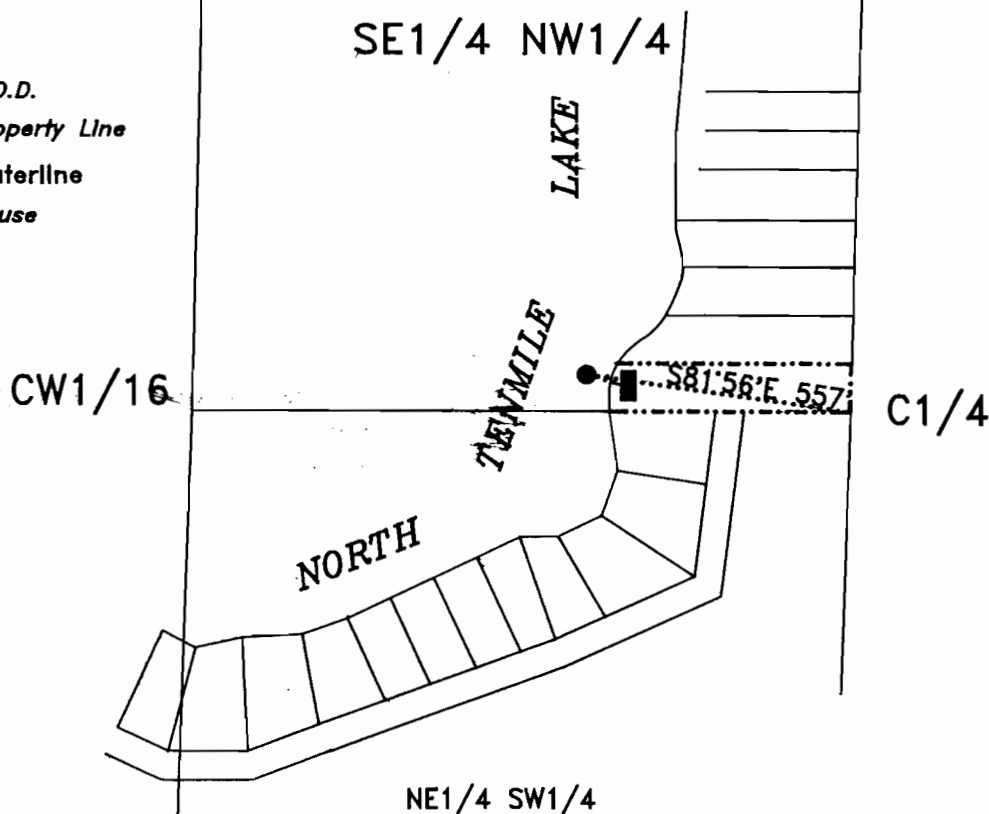


EXAMINERS DISCLAIMER STATEMENT

The preparation of this map was for the purpose of identifying the location of the Water Right only and has no intent to provide dimensions or location of property ownership lines.

FINAL PROOF SURVEY

IN THE NAME OF

Robert J. Harr

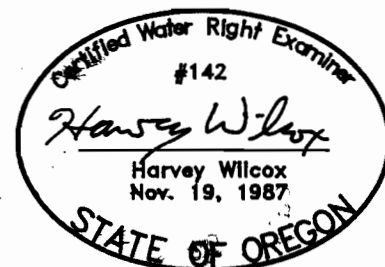

RENEWAL 6/30/00

Application No. S-81991

Permit No. 53450

Surveyed on 11/25/98 by H.A. Wilcox