
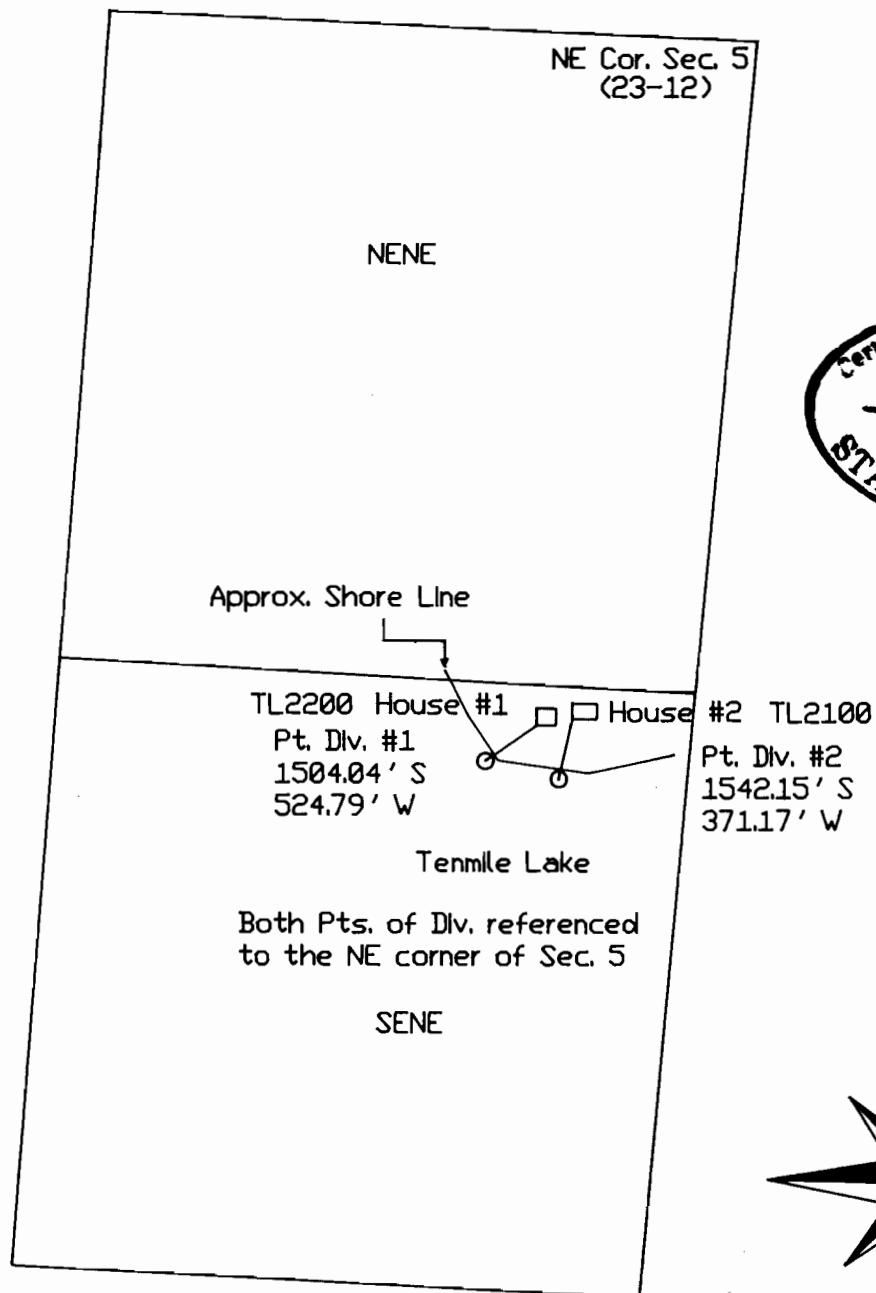


RECEIVED

OCT 23 2001

WATER RESOURCES DIV.
SALEM, OREGON

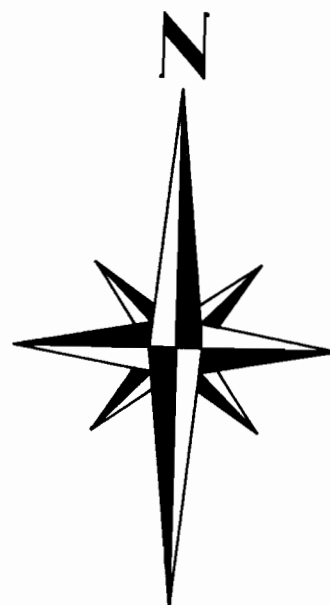

Scale: 1" = 400'

Final Proof Survey
App. S-83431 Permit 53399
In the name of John DeJung
Located in
SENE Sec. 5, T.23S, R.12W, W.M.

The purpose of this map is to
identify the location of the
water right. It is not intended
to identify property ownership
lines. Final proof survey
performed July 27, 2001.