

RECEIVED

JUN 8 1999


WATER RESOURCES DEPT.
SALEM, OREGON

CLAIM OF BENEFICIAL USE FINAL PROOF MAP

Located in the NE 1/4 NW 1/4 of Section 28
Township 23 South, Range 12 West, W.M.
Coos County, Oregon

Application S-83498 Permit 53402

TL 400

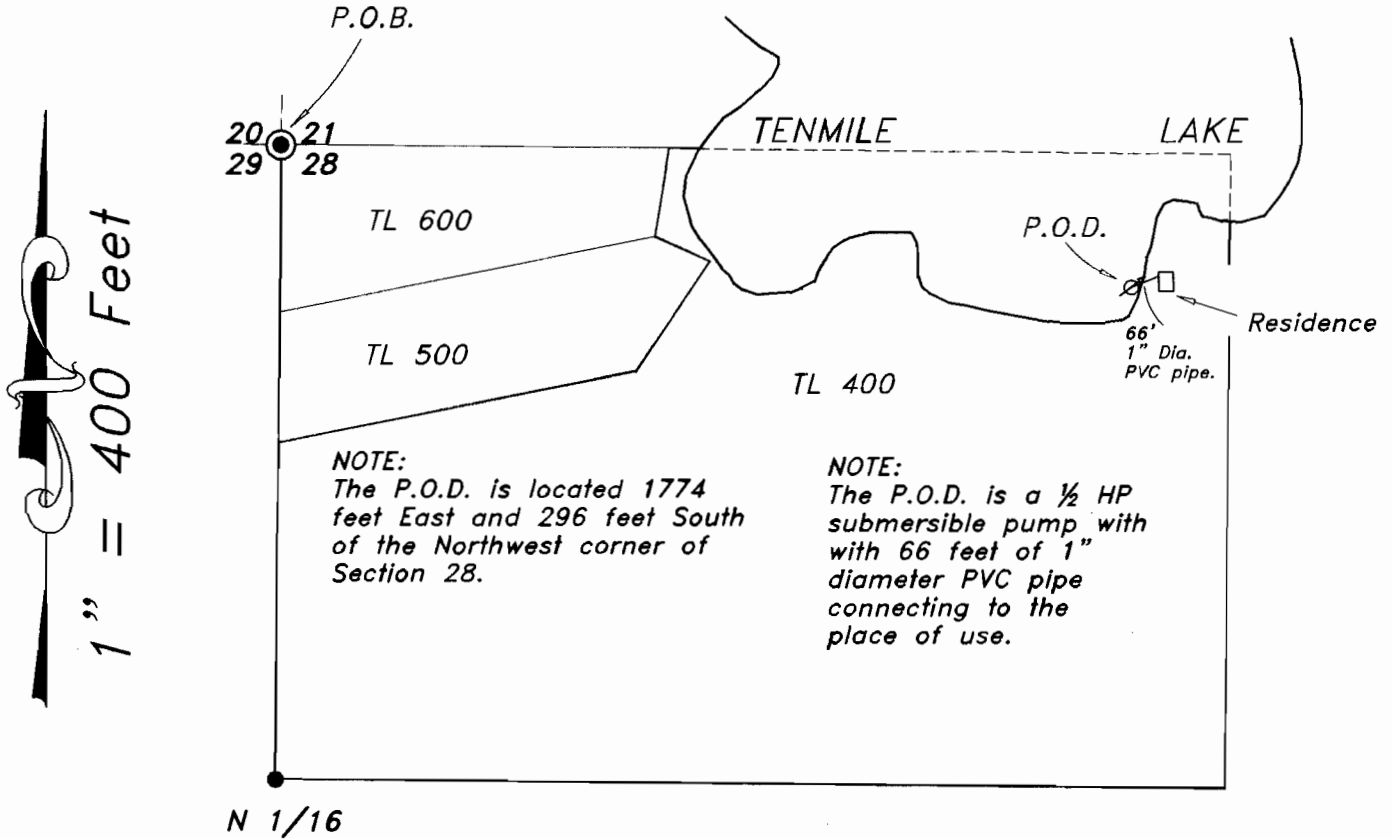

LEGEND

- P.O.B. 
- P.O.D. 
- PIPE 
- RESIDENCE 

PREPARED FOR: BJORN VIAN
PREPARED BY: DENNIS GOUDE
DATE PREPARED: June 1, 1999



EXPIRES 06/30/00

Stuntzner Engineering
& Forestry, LLC

ENGINEERING * LAND SURVEYING * FORESTRY
PLANNING * WATER RIGHTS

705 South 4th St.
Post Office Box 118
Coos Bay, Oregon 97420

Phone (541) 267-2872
Fax (541) 267-0588

EXAMINERS DISCLAIMER STATEMENT

The preparation of this map was for the purpose of identifying the location of the Water Right only and has no intent to provide dimensions or location of property ownership lines.