

CLAIM OF BENEFICIAL USE FINAL PROOF MAP

Located in the NW1/4 SW1/4 of Section 9
Township 23 South, Range 12 West, W.M.
Coos County, Oregon
Application S-83798 Permit 53549

Prepared For: Randy & Cindy Jones
Prepared By: Dennis Goude
Date Prepared: September 21, 1999

RECEIVED

SEP 29 1999

WATER RESOURCES DEPT.
SALEM, OREGON


Scale 1" = 100 Feet
Assessors Scale

NOTE:

The P.O.D. is a 1/2 HP pump the
foot valve is located 77 feet North
and 990 feet West from the South-
west 1/16 corner of Section 9.



EXPIRES 06/30/2001

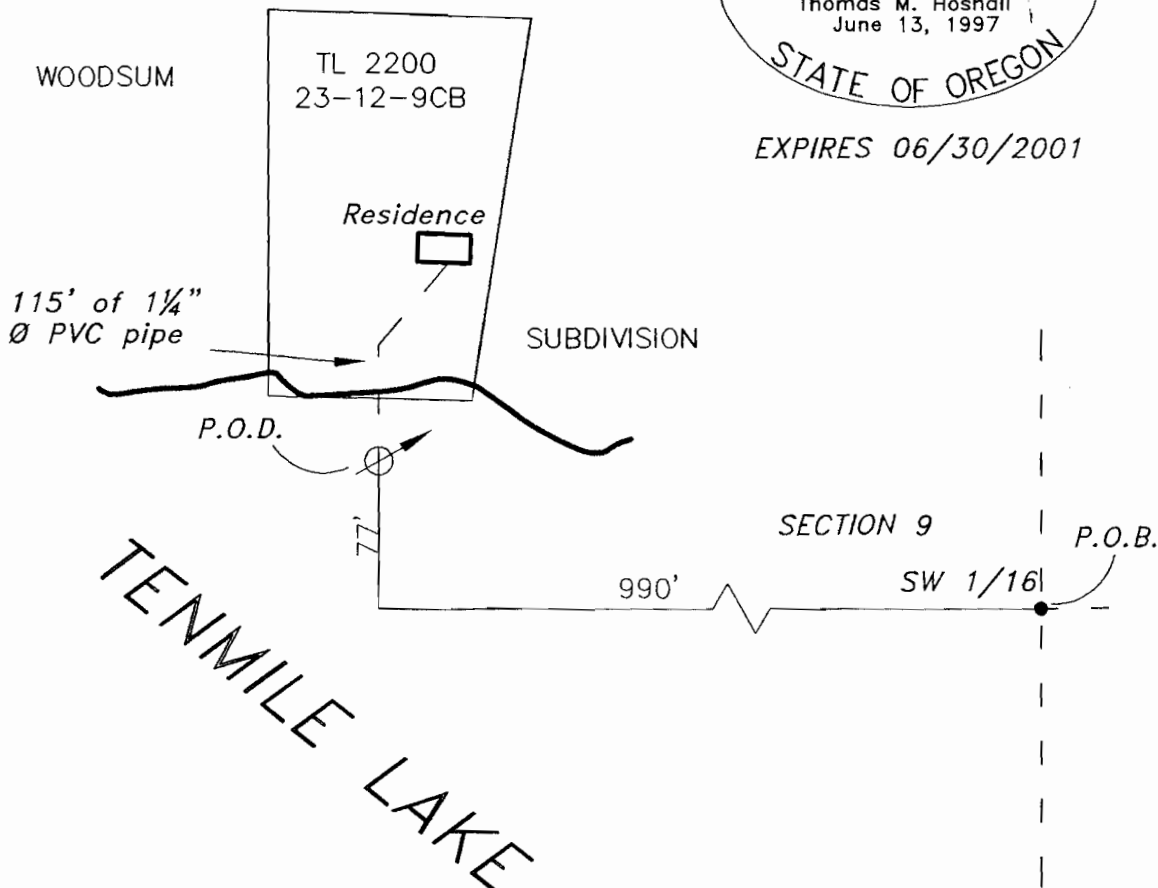

LEGEND

P.O.B. ●
P.O.D. ⊗
PIPE — —

EXAMINERS DISCLAIMER STATEMENT

The preparation of this map was for the purpose of
identifying the location of the Water Right only and
has no intent to provide dimensions or location of
property ownership lines.

*Stuntzner Engineering
& Forestry, L.L.C.*

ENGINEERING • LAND SURVEYING • FORESTRY
PLANNING • WATER RIGHTS

705 South 4th St.
Post Office Box 118
Coos Bay, Oregon 97420

Phone: (541) 287-28
Fax: (541) 287-05