

Tax Lot No. TL2903 23 12 20BD
Section 20 Township 23S Range 12W W.M.
Coos County

NW1/16

CN1/16

SE1/4 NW1/4

RECEIVED

AUG 13 1999

WATER RESOURCES DEPT
SALEM, OREGON

CW1/16

C1/4

N88°00'E 1211'

NE1/4 SW1/4


Tennile Lake

LEGEND

- HOME
- POINT OF DIVERSION
- WATERLINE
- PROPERTY LINE

EXAMINERS DISCLAIMER STATEMENT

The preparation of this map was for the purpose of identifying the location of the Water Right only and has no intent to provide dimensions or location of property ownership lines.

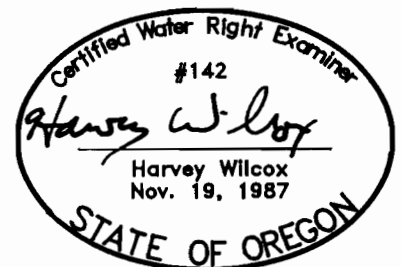

RENEWAL 6/30/00

FINAL PROOF SURVEY

IN THE NAME OF

Jim W. Campbell

Surveyed on 7/9/99 by H.A. Wilcox

Application No. S-83812
Permit No. 53533