

CLAIM OF BENEFICIAL USE
FINAL PROOF MAP

Located in the SW1/4 SW1/4 of Section 9
Township 23 South, Range 12 West, W.M.

Coos County, Oregon

Application S-83814 Permit 53610

RECEIVED

SEP 23 1999


WATER RESOURCES DEPT.
SALEM, OREGON

Prepared For: Don Burdg
Prepared By: Dennis Goude
Prepared: Sept. 14, 1998

LEGEND

P.O.B. ●

P.O.D. ⦿

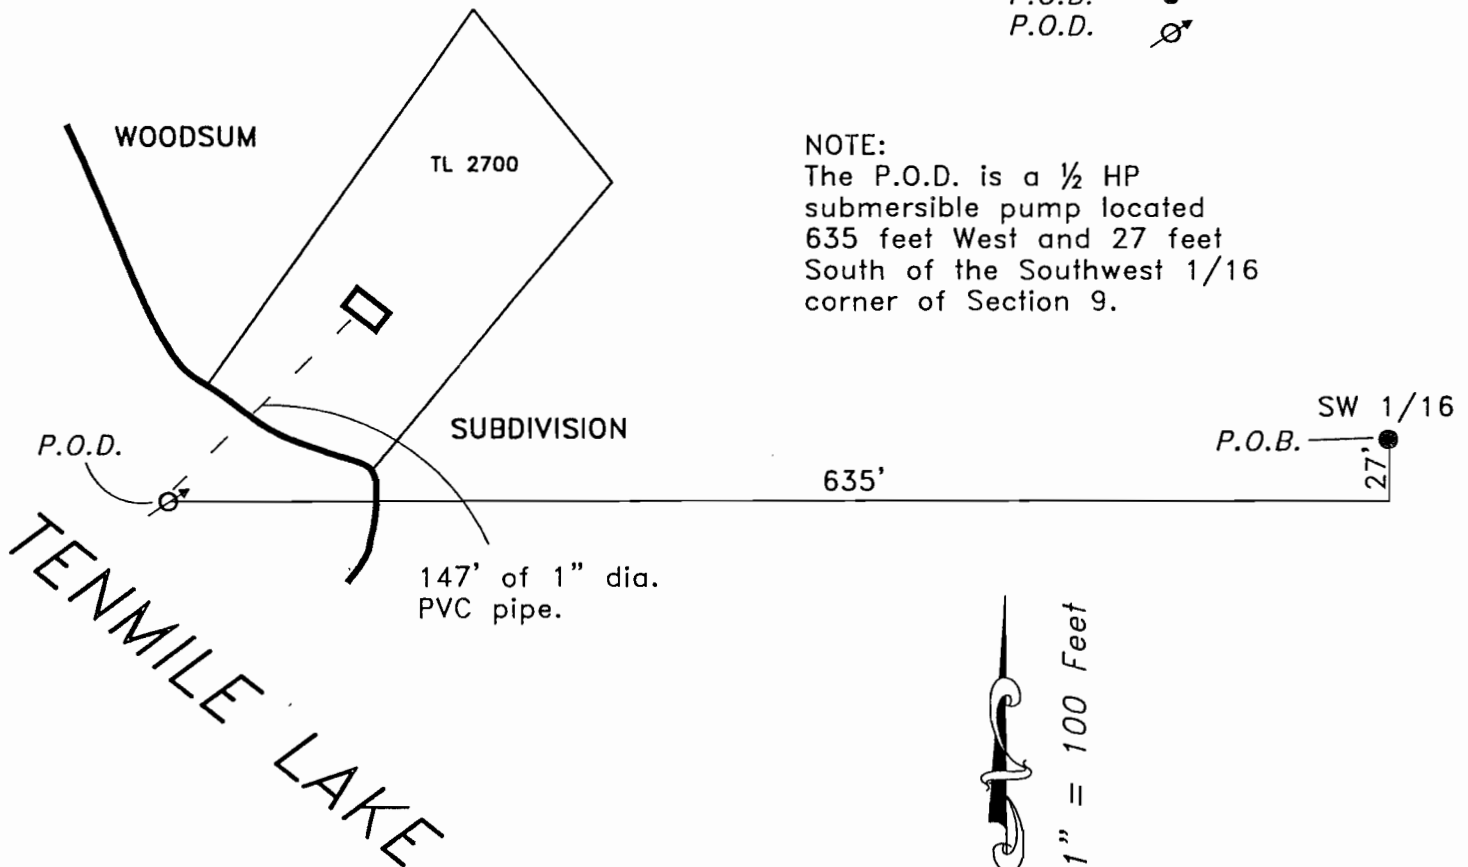

NOTE:

The P.O.D. is a 1/2 HP
submersible pump located
635 feet West and 27 feet
South of the Southwest 1/16
corner of Section 9.



EXPIRES 06/30/2001

EXAMINERS DISCLAIMER STATEMENT

The preparation of this map was for the purpose of
identifying the location of the Water Right only and
has no intent to provide dimensions or location of
property ownership lines.

Stuntzner Engineering
& Forestry, L.L.C.

ENGINEERING • LAND SURVEYING • FORESTRY
PLANNING • WATER RIGHTS

705 South 4th St.
Post Office Box 118
Coos Bay, Oregon 97420

Phone: (541) 267-2872
Fax: (541) 267-0588