

file copy
3/22/02
JLB



OTIS VALLEY IRRIGATION COMPANY

FINAL PROOF SURVEY
UNDER

Application No. R-33144 Permit No. R-4699
33145 31115
Surveyed June & Oct. 1955 by Larry Toll

T. 19 S., R. 36 E., W.M.

T. 20 S., R. 36 E., W.M.

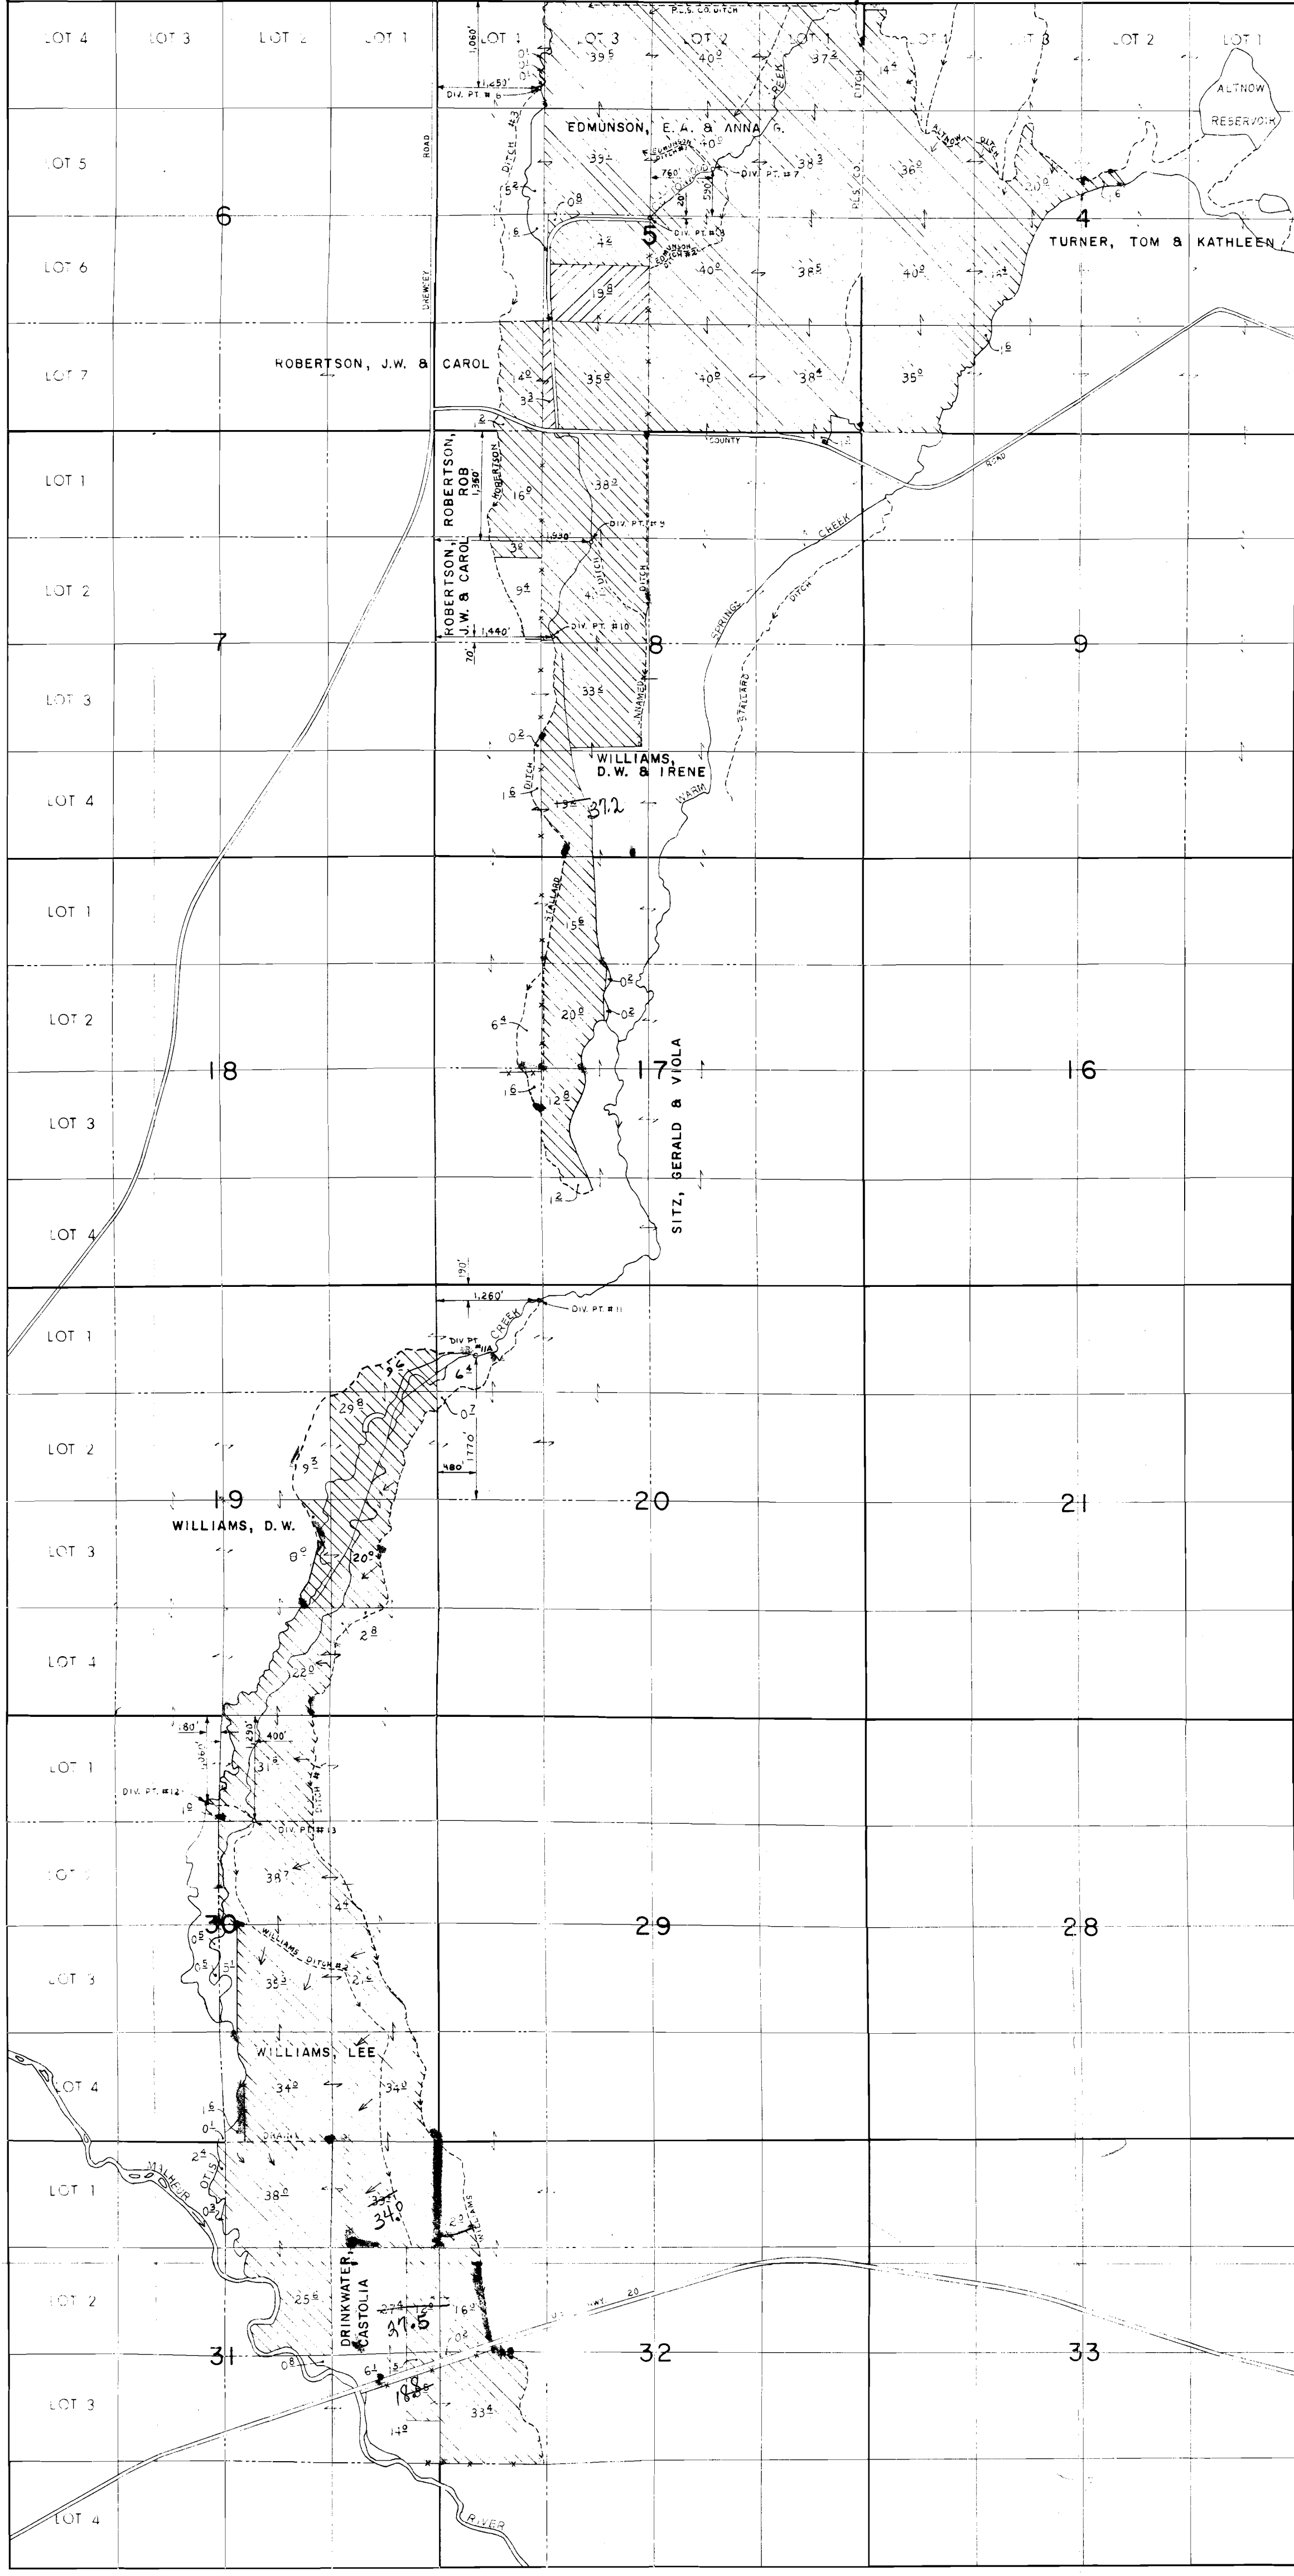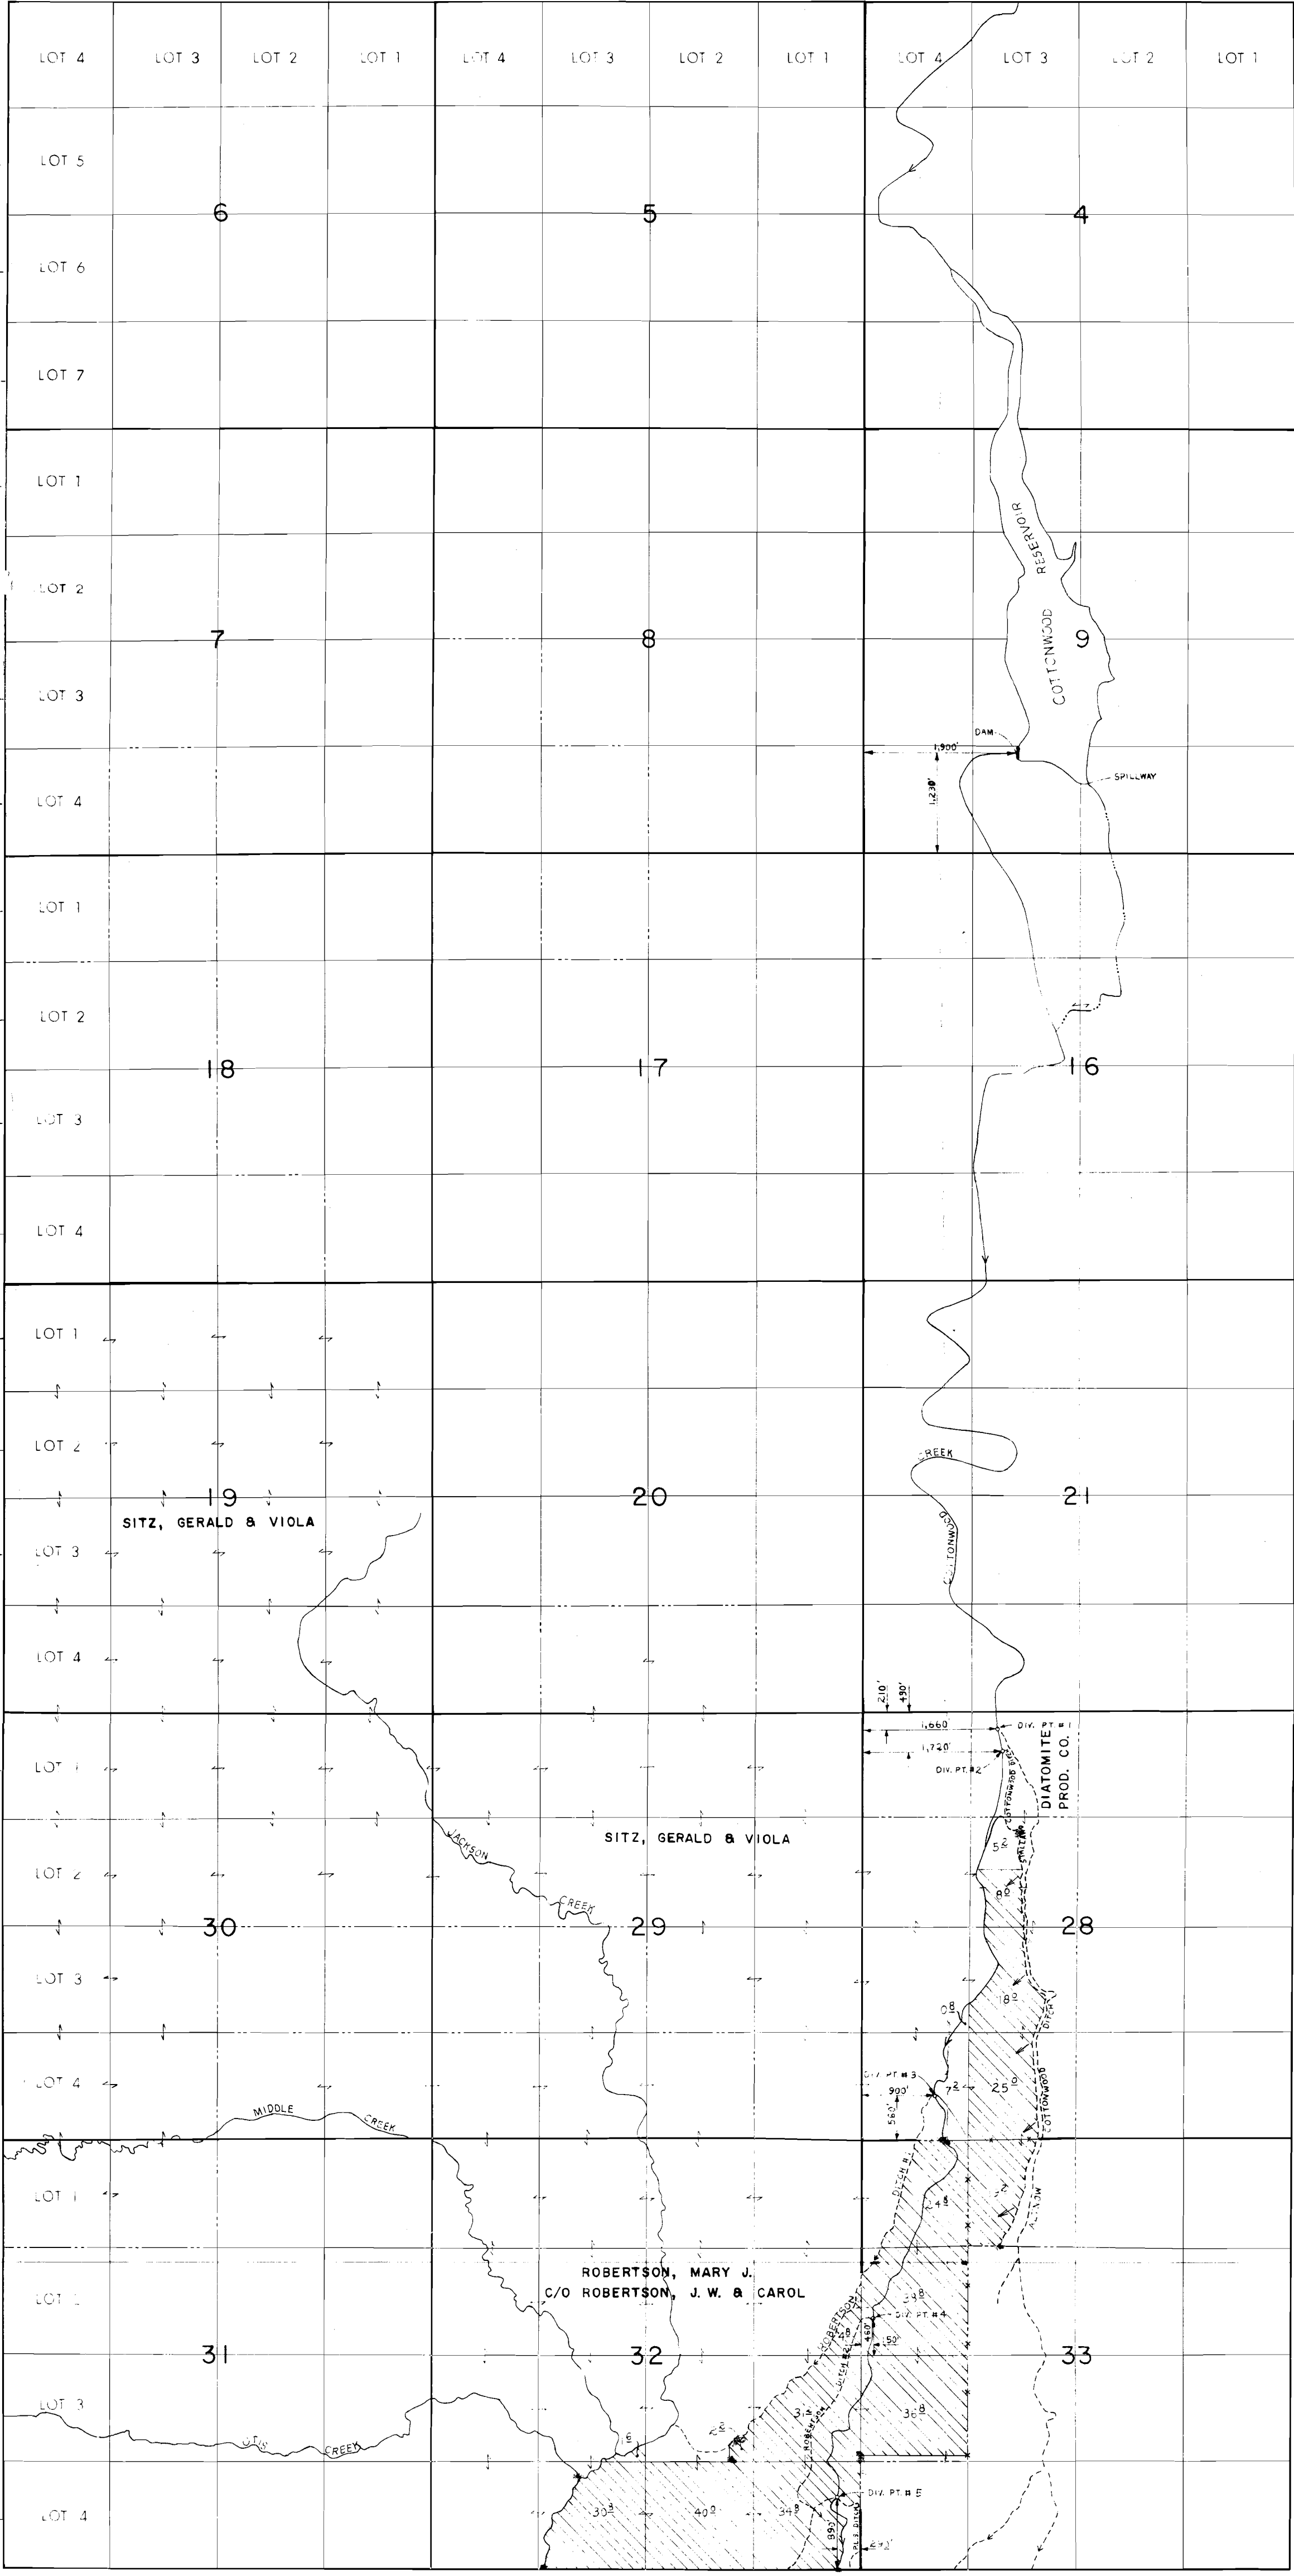

file copy
do not remove.
final proof
as corrected
for Cuts issued
3/22/02
JLB

RECEIVED
AUG 16 1959
WATER DIVISION
