


FINAL PROOF SURVEY MAP
T27S, R3W, WM

SCALE 1" = 1320'

DOUGLAS COUNTY

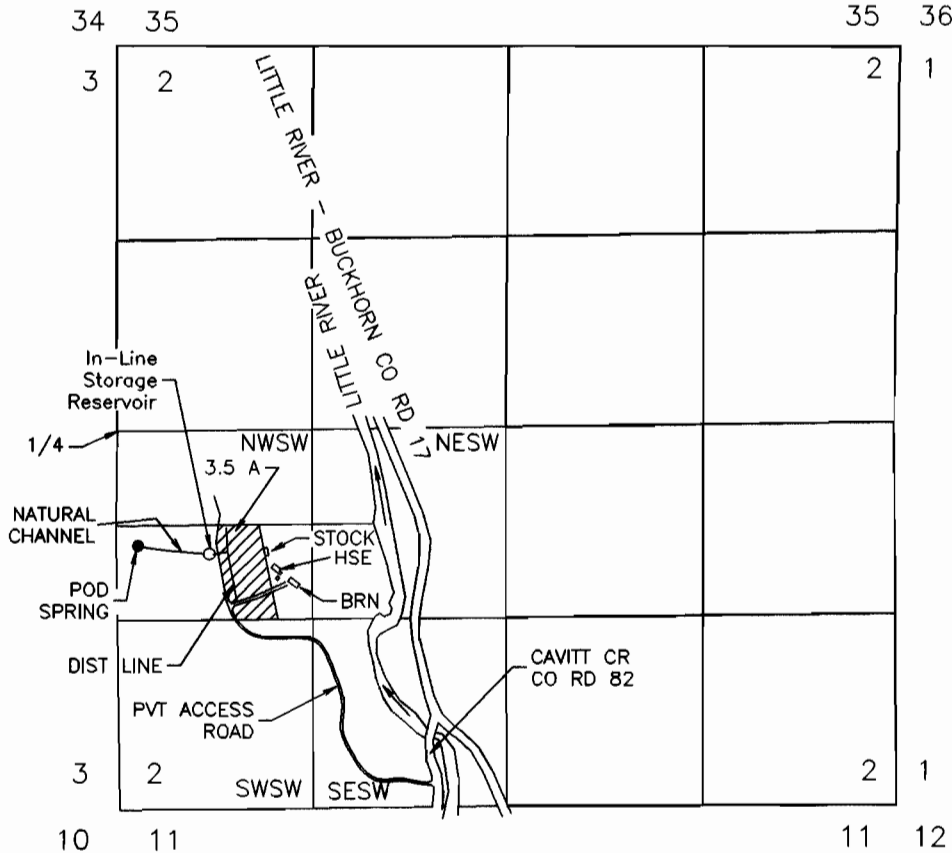

POD SPRING IS 780 FT S AND 140 FT E FROM W 1/4 COR SEC 2

FINAL PROOF SURVEY
UNDER

Application No. S-71833 Permit No. 52217

IN NAME OF

Alexander Mornarich

Surveyed August 15, 1999 by M E Farr

THIS IS A LOCATION MAP FOR A FINAL PROOF SURVEY BY ALEXANDER MORNARICH. THIS MAP IS FOR THE PURPOSE OF IDENTIFYING THE LOCATION OF THE WATER RIGHT ONLY AND IS NOT INTENDED TO PROVIDE LEGAL DIMENSIONS OR LOCATIONS OF PROPERTY OWNERSHIP LINES.

MAP PREPARED FOR:
ALEXANDER MORNARICH
569 CONIFER LANE
GLIDE, OR 97443

MAP PREPARED BY:
MAURICE E FARR, CWRE
395 NE KIRBY AVENUE
ROSEBURG, OR 97470

RECEIVED

SEP 27 1999

WATER RESOURCES DEPT
SALEM, OREGON

