


T26S.R3W.W.M.

1 INCH = 1320 FEET

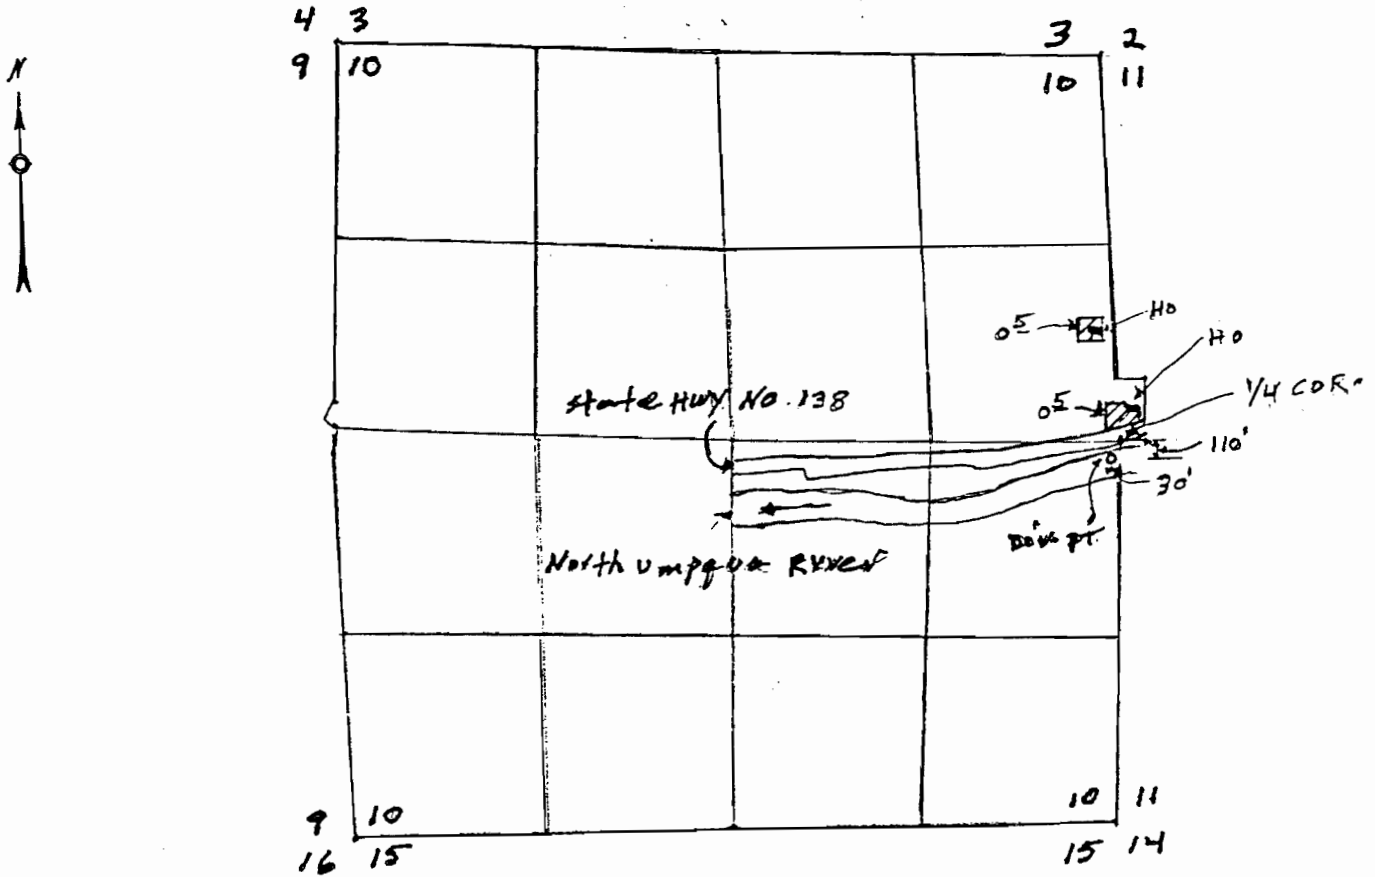

THE PURPOSE OF THIS MAP IS TO IDENTIFY THE LOCATION OF THE WATER RIGHT. IT IS NOT INTENDED TO PROVIDE INFORMATION RELATIVE TO THE LOCATION OF PROPERTY OWNERSHIP BOUNDARY LINES.



FINAL PROOF SURVEY UNDER

Application No. 72084 Permit No. 52550

IN NAME OF

JACK A. CURRY & JAMES M. MARIER

Surveyed APR 16 1998 by DUANE KIRBY