



T23S.R4W.W.M.

1 INCH = 1320 FEET

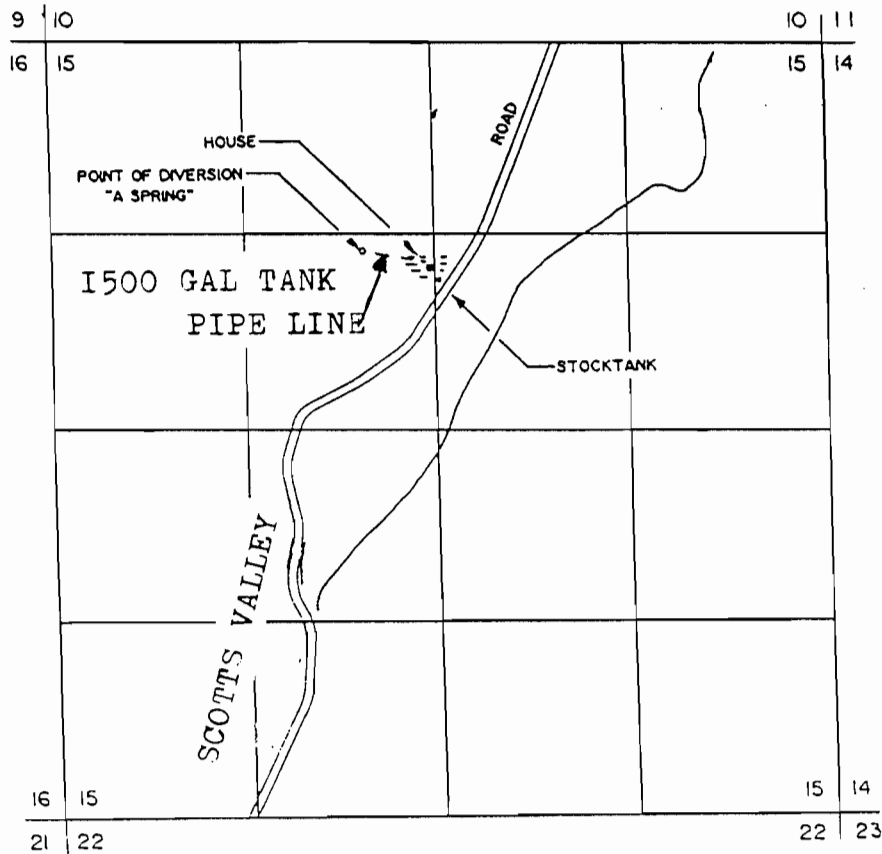

THE PURPOSE OF THIS MAP IS TO IDENTIFY THE LOCATION OF THE WATER RIGHT. IT IS NOT INTENDED TO PROVIDE INFORMATION RELATIVE TO THE LOCATION OF PROPERTY OWNERSHIP BOUNDARY LINES.

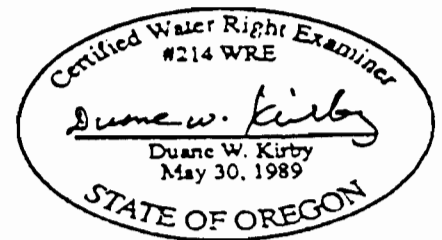

FINAL PROOF SURVEY UNDER

Application No. 72206 Permit No. 52181
IN NAME OF
MARIAN F. THIES

Surveyed NOV 6 1998 by DUANE KIRBY

RECEIVED

NOV 13 1998

WATER RESOURCES DEPT.
SALEM, OREGON