


WATER RIGHT FINAL PROOF MAP
T22S & T23S, R4W.WM

DOUGLAS COUNTY
SCALE 1" = 1320'

RECEIVED

OFC 10 1996

WATER RESOURCES DEPT.
SALEM OREGON

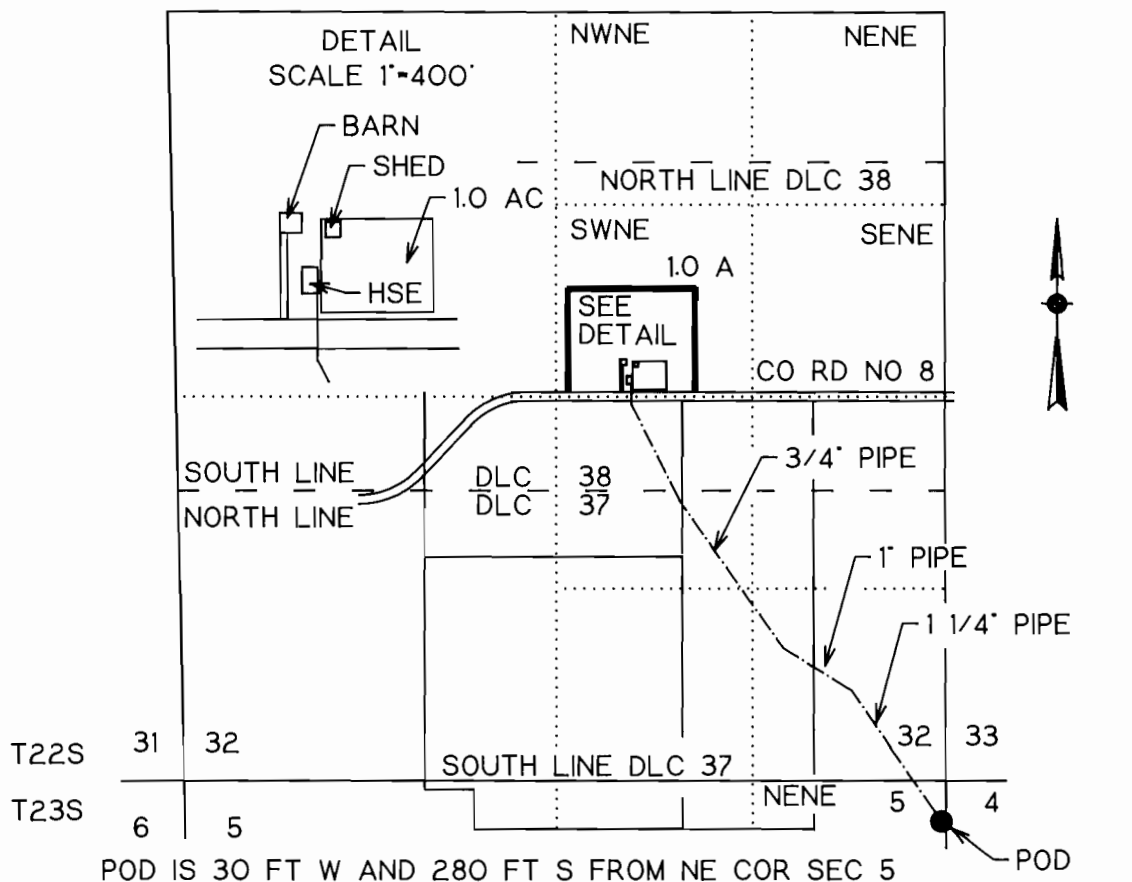

FINAL PROOF SURVEY

UNDER

Application No. S-72452 Permit No. 52663

IN NAME OF

ELZO OR ROSEMARY BEAM

Surveyed November 18, 1996, by M E Farr

1960 SW BURDETTE DR. ROSEBURG, OR 97470

1000 GAL IN-SYSTEM
FIBERGLAS STORAGE TANK

ELZO OR ROSEMARY BEAM
2360 LOWELL AVE
RICHMOND, CA 94804



THIS IS A LOCATION MAP FOR A WATER RIGHT FINAL PROOF SURVEY BY ELZO OR ROSEMARY BEAM. THIS MAP IS FOR THE PURPOSE OF IDENTIFYING THE LOCATION OF THE WATER RIGHT ONLY AND IS NOT INTENDED TO PROVIDE LEGAL DIMENSIONS OR LOCATIONS OF PROPERTY OWNERSHIP LINES.