

12 *copy 11/30/01*


T.19S., R.9W., W.M.

SECTION 14

9257 7462
JUL 10 1997
WATER RESOURCES DEPT.
SALEM, OREGON

THE PURPOSE FO THIS MAP IS TO IEDNTIFY THE LOCATION OF THE WATER RIGHT. IT IS NOT INTENDED TO PROVIDE INFORMATION RALATIVE TO THE LOCATION OF PROPERTY OWNERSHIP BOUNDARY LINES.

copy

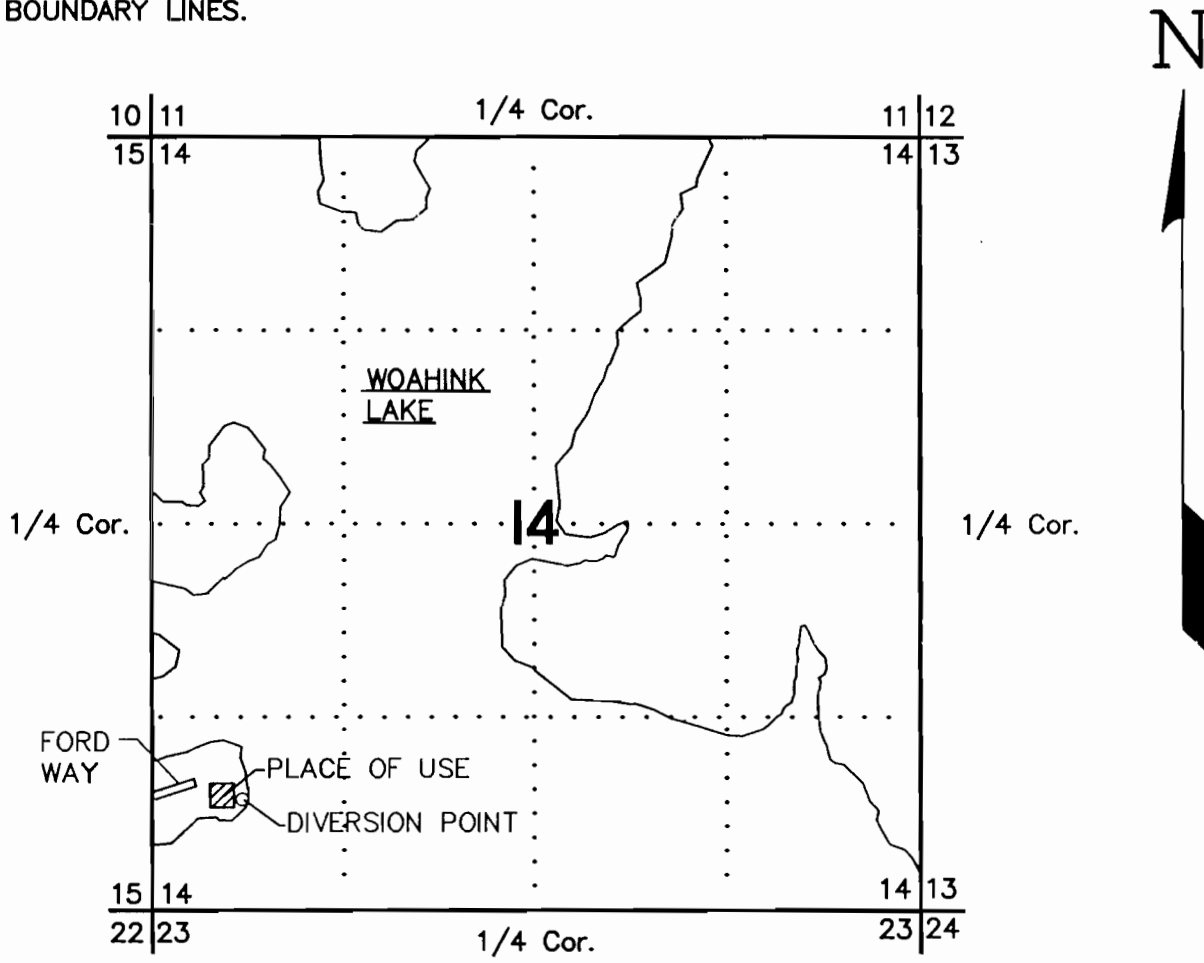

SCALE 1" = 1320'

THE DIVERSION POINT IS LOCATED 550' EAST AND 700' NORTH OF THE S.W. CORNER OF SECTION 14

FINAL PROOF SURVEY

UNDER

Application No. S73246 Permit No. 52332

IN THE NAME OF

JOSEPHINE E. BUEHLER



Surveyed Sept. 26, 19 96 by O. GROVER