


MAY 28 1993

WATER RESOURCES DEPT
SALEM, OREGON

W.M.

Tax Lot No. TL500 23 12 21BC
Section 21 Township 23S Range 12W
Coos County

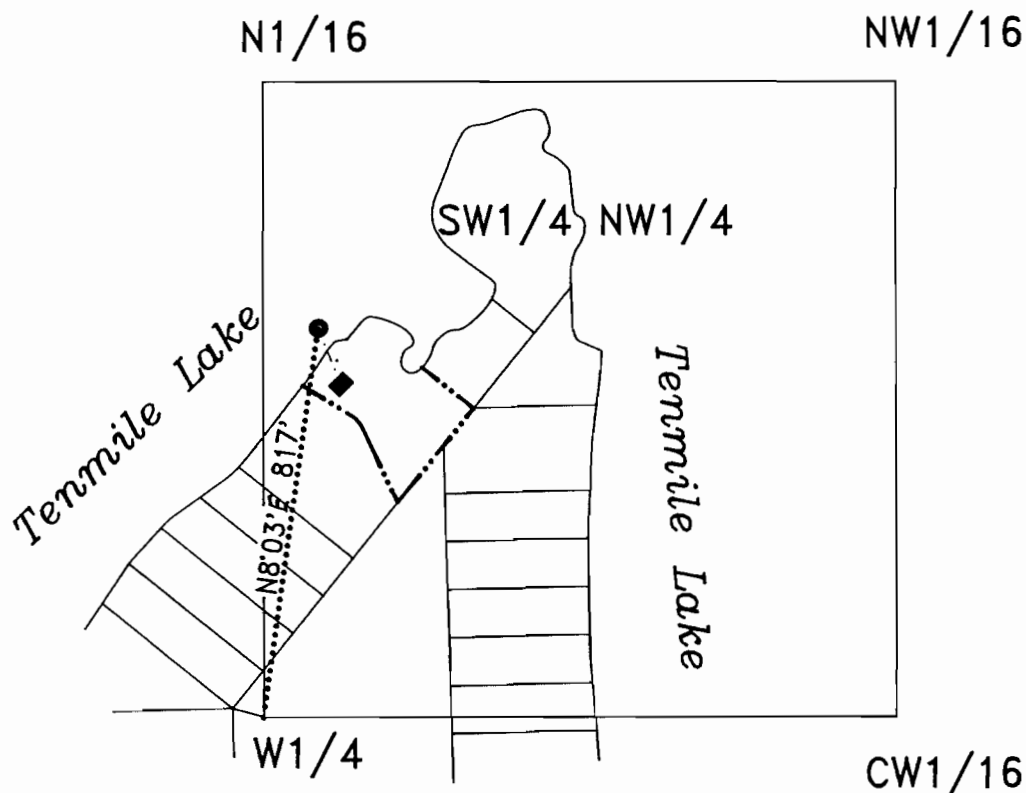

Scale 1" = 400'

Legend

- P.O.D.
- Property Line
- Waterline
- House

EXAMINERS DISCLAIMER STATEMENT


The preparation of this map was for the purpose of identifying the location of the Water Right only and has no intent to provide dimensions or location of property ownership lines.

FINAL PROOF SURVEY

IN THE NAME OF

June G. Christie

Surveyed on 10/2/97 by H.A. Wilcox

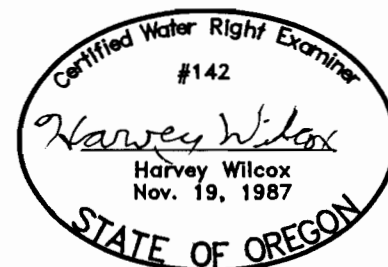

RENEWAL 6/30/98

Application No. S-81129

Permit No. 54009