


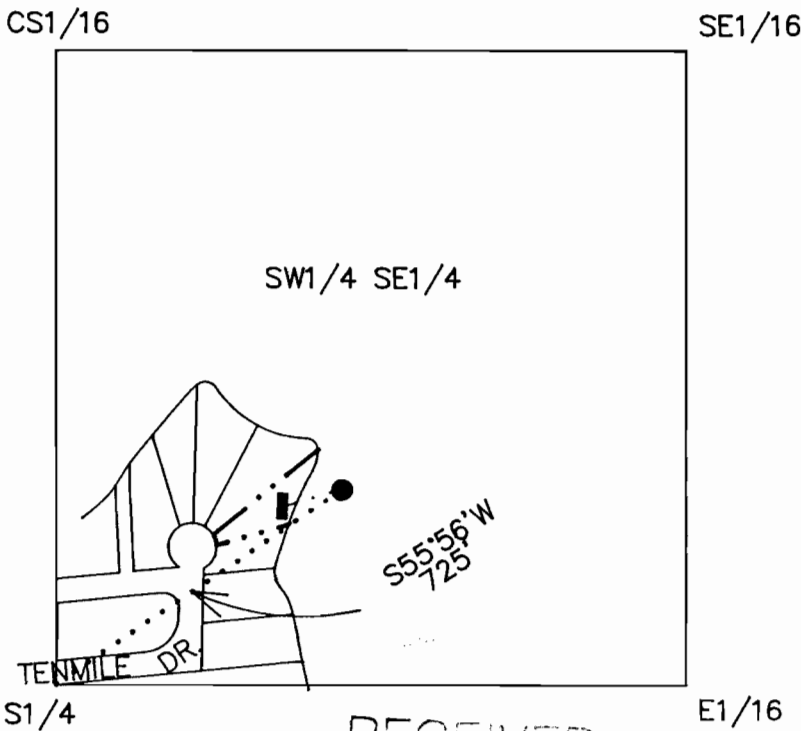

LEGEND

- HOME
- POINT OF DIVERSION
- - - - WATERLINE
- . . - PROPERTY LINE

EXAMINERS DISCLAIMER STATEMENT

The preparation of this map was for the purpose of identifying the location of the Water Right only and has no intent to provide dimensions or location of property ownership lines.


FINAL PROOF SURVEY
IN THE NAME OF
Kenneth L. & Barbara A. Fowler

Surveyed on 8/18/00 by H.A. Wilcox

RECEIVED

SEP 18 2000

WATER RESOURCES DEPT.
SALEM, OREGON

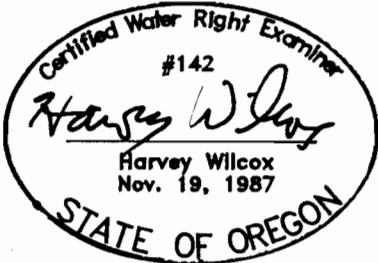

RENEWAL 6/30/02

Application No. S-81594
Permit No. 53284