



RECEIVED

JAN 03 2000

WATER RESOURCES DEPT.
SALEM, OREGON

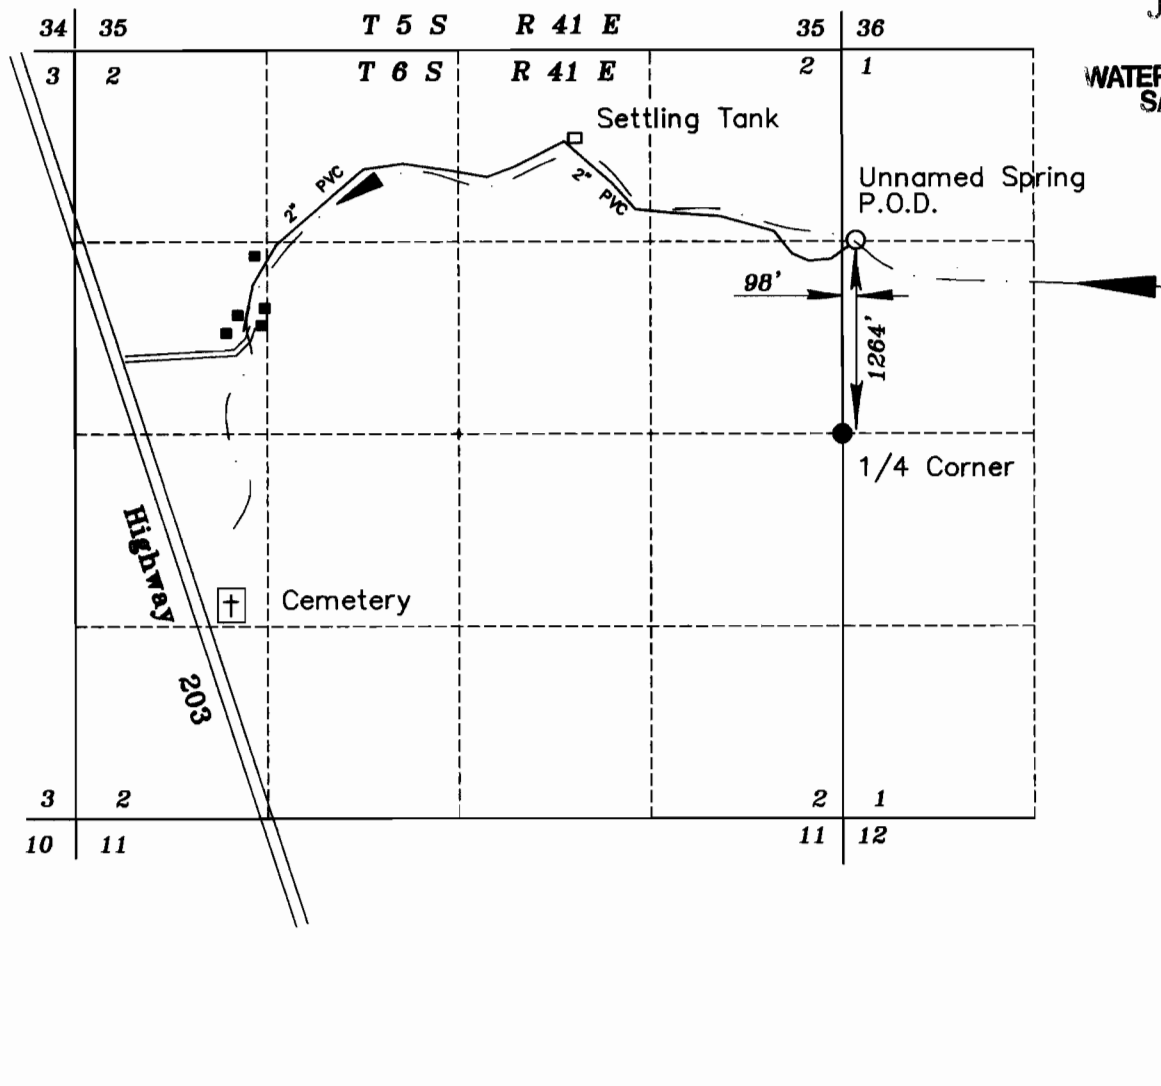

SCALE 1" = 1320'

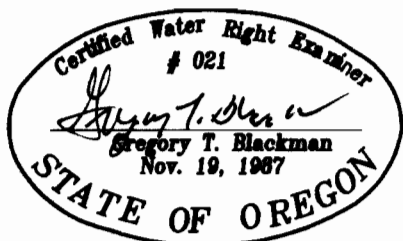

NOTE: The preparation of this map was for the purpose of identifying the location of the proposed water right and has no intent to provide dimensions or location of property ownership lines. Location information shown hereon was furnished by the applicant.

**FINAL PROOF MAP OF
WATER RIGHTS FROM A
UNNAMED SPRING FOR**

Theodore C. Brown

BY

**BAGETT - GRIFFITH & BLACKMAN
2006 ADAMS AVENUE
LAGRANDE, OREGON 97850**

DECEMBER 21, 1999

APPLICATION NO. S-83561

PERMIT NUMBER P-53497